


| | | | | | |
|---------|-------------------------|--|----------------|-----------------|--------------|
| 1 | LOCATION OF WATER WELL: | Fraction | Section Number | Township Number | Range Number |
| County: | GRAY | SW ¹ / ₄ SW ¹ / ₄ SE ¹ / ₄ | 36 | 25 S | 29 W |

Distance and direction from nearest town or city street address of well if located within city?
 Under city water tower

2 WATER WELL OWNER: City of Ingalls
 RR #, St. Address, Box #: 220 S. Main
 City, State, ZIP Code: Ingalls, Ks 67853
 Board of Agriculture, Division of Water Resources
 Application Number: 19821

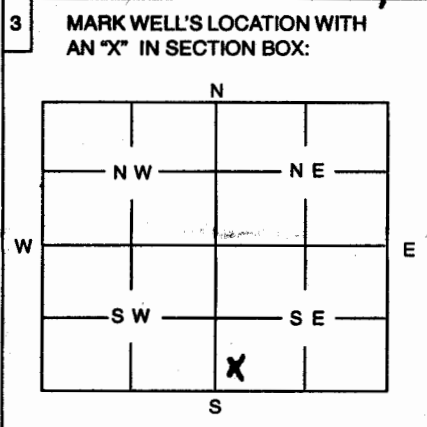

4 DEPTH OF WELL 266 ft
 WELL'S STATIC WATER LEVEL 25 ft.
 WELL WAS USED AS:
 1 Domestic 5 Public Water Supply 9 Dewatering
 2 Irrigation 6 Oil Field Water Supply 10 Monitoring Well
 3 Feedlot 7 Domestic (Lawn & Garden) 11 Injection Well
 4 Industrial 8 Air Conditioning 12 Other

Was a chemical / bacteriological sample submitted to Department? Yes No
 If yes, mo/day/yr sample was submitted N/A

Water Well Disinfected: Yes ... X ... No

5 TYPE OF BLANK CASING USED:
 1 Steel 3 RMP (SR) 5 Wrought 7 Fiberglass 9 Other (Specify below)
 2 PVC 4 ABS 6 Asbestos-Cement 8 Concrete Tile

Blank casing diameter 10 in. Was casing pulled? Yes No ... X
 Casing height above or below land surface in. If yes, how much

6 GROUT PLUG MATERIAL: 1 Neat cement 2 Cement grout 3 Bentonite 4 Other

Grout Plug Intervals: From ... 100 ... ft. to ... 3 ... ft., From ft. to ft., From to ft.

What is the nearest source of possible contamination:
 1 Septic tank 6 Seepage pit 11 Fuel storage 16 Other (specify below)
 2 Sewer lines 7 Pit privy 12 Fertilizer storage name known
 3 Watertight sewer lines 8 Sewage lagoon 13 Insecticide storage
 4 Lateral lines 9 Feedyard 14 Abandoned water well
 5 Cess Pool 10 Livestock pens 15 Oil well/Gas well

Direction from well? How many feet?

| FROM | TO | PLUGGING MATERIALS |
|------|-----|-----------------------------------|
| 266 | 100 | chlorinated sand |
| 100 | 3 | cement grout |
| 3 | 0 | To be done by the city of Ingalls |
| | | |
| | | |
| | | |

(100-10 perforated with knife)

7 CONTRACTOR'S OR LANDOWNER'S CERTIFICATION: This water well was plugged under my jurisdiction and was completed on (mo/day/year) 6/29/04 and this record is true to the best of my knowledge and belief. Kansas Water Well Contractor's License No. 581 This Water Well Record was completed on (mo/day/year) 7/19/04 under the business name of Kayne Christensen Company by (signature) Russell W. Kedd

INSTRUCTIONS: Use typewriter or ball point pen. Please press firmly and print clearly. Please fill in blanks, underline or circle the correct answers. Send top three copies to Kansas Department of Health and Environment, Bureau of Water, Topeka, Kansas 66620-0001. Telephone: 785/296-3565. Send one to Water Well Owner and retain one for your records.