

WATER WELL RECORD

Form WWC-5


Division of Water Resources App. No.

23,547

1 LOCATION OF WATER WELL: County: GRAY Fraction 1/4 SE 1/4 NW 1/4 NW 1/4 Section Number 31 Township No. T 25 S Range Number R 29 [ ] E [X] W

Street/Rural Address of Well Location; if unknown, distance & direction from nearest town or intersection: If at owner's address, check here [ ]. SOUTHEAST SIDE OF CHARLESTON - 2-1/2 MILES SOUTH, 1-1/2 MILES EAST, 4,280' N. & 4,190' W.

2 WATER WELL OWNER: AGRO HOLDINGS, LLC - 613 RR#, Street Address, Box #: PO BOX 1014 City, State, ZIP Code : NEW YORK, NEW YORK 10021

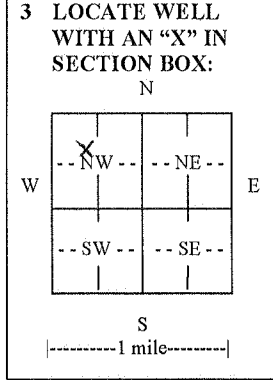

4 DEPTH OF COMPLETED WELL 190 ft. Depth(s) Groundwater Encountered (1) 89 ft. (2) ft. (3) ft. WELL'S STATIC WATER LEVEL 89 ft. below land surface measured on mo/day/yr. 1-24-12

5 TYPE OF CASING USED: [X] Steel [ ] PVC [ ] Other CASING JOINTS: [ ] Glued [ ] Clamped [X] Welded [ ] Threaded Casing diameter 16 in. to 105 ft., Diameter in. to ft., Diameter in. to ft.

TYPE OF SCREEN OR PERFORATION MATERIAL: [X] Steel [ ] Stainless Steel [ ] PVC [ ] Brass [ ] Galvanized Steel [ ] None used (open hole) SCREEN OR PERFORATION OPENINGS ARE: [ ] Continuous slot [X] Mill slot [ ] Gauze wrapped [ ] Torch cut [ ] Drilled holes [ ] None (open hole)

6 GROUT MATERIAL: [ ] Neat cement [X] Cement grout [ ] Bentonite [ ] Other Grout Intervals: From 0 ft. to 95 ft., From ft. to ft., From ft. to ft. What is the nearest source of possible contamination: [ ] Septic tank [ ] Lateral lines [ ] Pit privy [ ] Livestock pens [ ] Insecticide storage [ ] Other (specify below)

Table with 6 columns: FROM, TO, LITHOLOGIC LOG, FROM, TO, LITHO. LOG (cont.) or PLUGGING INTERVALS. Row 2 contains 'SEE ATTACHED LOG'.

7 CONTRACTOR'S OR LANDOWNER'S CERTIFICATION: This water well was [X] constructed, [ ] reconstructed, or [ ] plugged under my jurisdiction and was completed on (mo/day/year) 1-24-12 and this record is true to the best of my knowledge and belief.

INSTRUCTIONS: Use typewriter or ball point pen. PLEASE PRESS FIRMLY and PRINT clearly. Please fill in blanks and check the correct answers. Send three copies (white, blue, pink) to Kansas Department of Health and Environment, Bureau of Water, Geology Section, 1000 SW Jackson St., Suite 420, Topeka, Kansas 66612-1367.

*The  
Professionals*

# MINTER-WILSON DRILLING CO.

INCORPORATED

Irrigation  
and Domestic  
Water Systems  
Complete Installation  
and Repairing

Phone 620-276-8269 • P.O. Box A • GARDEN CITY, KANSAS 67846

NAME           TIM DEWEY FARMS  
COUNTY       GRAY  
DATE           8-31-11

LOCATION:       NW 1/4 31-25-29 - RENICK # 64 - 600 FT. NORTHWEST OF WELL  
  
                  STATIC WATER LEVEL - APPROX. 70 FT.

## TEST # 1

0' TO 1' - TOP SOIL  
1' TO 3' - BROWN SANDY CLAY  
3' TO 9' - FINE TO MEDIUM COARSE GRAVEL  
9' TO 33' - BROWN CLAY  
33' TO 50' - BROWN CLAY WITH SMALL GRAVEL STREAKS  
50' TO 70' - FINE TO MEDIUM SAND & GRAVEL  
70' TO 85' - BROWN CLAY  
85' TO 90' - FINE TO MEDIUM SAND & GRAVEL  
90' TO 100' - BROWN CLAY  
100' TO 112' - FINE TO MEDIUM SAND & GRAVEL - 10% CLAY  
112' TO 141' - BROWN CLAY  
141' TO 151' - FINE TO MEDIUM SAND & GRAVEL  
151' TO 170' - FINE TO MEDIUM SAND & GRAVEL - 10% CLAY  
170' TO 181' - FINE TO MEDIUM SAND & GRAVEL-BROWN & YELLOW ROCK MIXED  
181' TO 187' - BROWN & YELLOW CLAY  
187' TO 189' - YELLOW CLAY  
189' TO 200' - SHALE