


1] LOCATION OF WATER WELL: Fraction SW ¼ NE ¼ SE ¼ Section Number 36 Township Number T 25 S Range Number R 29 EW

Distance and direction from nearest town or city street address of well if located within city?
 NW of 4th & Edwards Sts intersection, Ingalls

2] WATER WELL OWNER: Kansas Dept. of Health & Environment
 RR#, St. Address, Box # : 1000 SW Jackson St., Suite 410 Board of Agriculture, Division of Water Resources
 City, State, ZIP Code : Topeka, Kansas 66612-1367 Application Number:

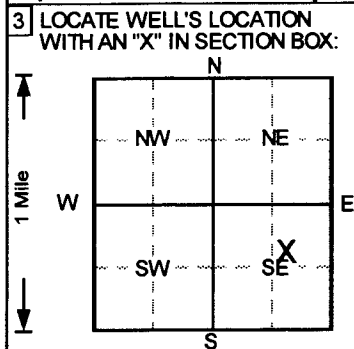

4] DEPTH OF COMPLETED WELL: 240 ft ELEVATION: 0
 Depth(s) Groundwater Encountered 1. ft 2. ft 3. ft
 WELL'S STATIC WATER LEVEL ft below land surface measured on mo/day/yr
 Pump test data: Well water was NA ft after hours pumping gpm
 Est Yield NA gpm; Well water was ft after hours pumping gpm
 Bore Hole Diameter 8.75 in. to 247 ft, and in. to ft
 WELL WATER TO BE USED AS: 5 Public water supply 8 Air conditioning 11 Injection well
 1 Domestic 3 Feedlot 6 Oil field water supply 9 Dewatering 12 Other (Specify below)
 2 Irrigation 4 Industrial 7 Lawn and garden only 10 Monitoring well
 Was a chemical/bacteriological sample submitted to Department? Yes No; If yes, mo/day/yr sample was submitted
 Water Well Disinfected? Yes No

5] TYPE OF BLANK CASING USED: 1 Steel 2 PVC 3 RMP (SR) 4 ABS 5 Wrought iron 6 Asbestos-Cement 7 Fiberglass 8 Concrete tile 9 Other (specify below)
 Blank casing diameter 4 in. to 220 ft, Dia in. to ft, Dia in. to ft
 Casing height above land surface in., weight lbs./ft. Wall thickness or gauge No. Sch. 80
 TYPE OF SCREEN OR PERFORATION MATERIAL: 1 Steel 2 Brass 3 Stainless steel 4 Galvanized steel 5 Fiberglass 6 Concrete tile 7 PVC 8 RMP (SR) 9 ABS 10 Asbestos-cement 11 Other (specify) 12 None used (open hole)
 SCREEN OR PERFORATION OPENINGS ARE: 1 Continuous slot 2 Louvered shutter 3 Mill slot 4 Key punched 5 Gauzed wrapped 6 Wire wrapped 7 Torch cut 8 Saw cut 9 Drilled holes 10 Other (specify) 11 None (open hole)
 SCREEN-PERFORATED INTERVALS: From 220 ft to 240 ft, From ft to ft, From ft to ft
 GRAVEL PACK INTERVALS: From 217 ft to 247 ft, From ft to ft, From ft to ft

6] GROUT MATERIAL: 1 Neat cement 2 Cement grout 3 Bentonite 4 Other Concrete
 Grout intervals: From 0 ft to 2 ft, From 2 ft to 21 ft, From ft to ft
 What is the nearest source of possible contamination: 1 Septic tank 2 Sewer lines 3 Watertight sewer lines 4 Lateral lines 5 Cess pool 6 Seepage pit 7 Pit privy 8 Sewage lagoon 9 Feedyard 10 Livestock pens 11 Fuel storage 12 Fertilizer storage 13 Insecticide storage 14 Abandoned water well 15 Oil well/Gas well 16 Other (specify below)
 Direction from well? How many feet? 0

FROM	TO	LITHOLOGIC LOG	FROM	TO	PLUGGING INTERVALS
0	7	Sand, f-m, silty, clayey, V. Pale Orange			
7	11	Clay, sandy (f-c), Pale Yellowish Brown			
11	44	Sand, f-m, Pale Yellowish Brown			
44	70	Sand, f-c, gravelly, Pale Yellowish Brown			
70	85	Sand, f-c, some clay, Pale Yellowish Brown			
85	95	Sand, f-c, clayey, Pale Yellowish Brown			
95	100	Clay, sandy (f-m), Pale Yellowish Brown			
100	190	Sand, f-c, some clay, Pale Yellowish Brown			
190	205	Sand, f-c, clayey, Pale Yellowish Brown			
205	220	Clay, sandy (f-c), Grayish Orange			
220	247	Shale, sl. wthrd., Dusty Yellowish Brown			
					MW-6D, Flushmount

7] CONTRACTOR'S OR LANDOWNER'S CERTIFICATION: This water well was (1) constructed, (2) reconstructed, or (3) plugged under my jurisdiction and was completed on (mo/day/year) 4/7/2015 and this record is true to the best of my knowledge and belief.
 Kansas Water Well Contractor's License No. 527. This Water Well Record was completed on (mo/day/yr) 4/21/2015 under the business name of GeoCore, Inc. by (signature) Dale Kelly

OFFICE USE ONLY
T
R
EW
SEC.