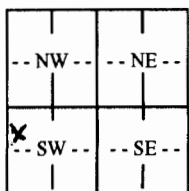


WATER WELL RECORD

Form WWC-5

Division of Water Resources App. No.

1 LOCATION OF WATER WELL: County: Gray	Fraction ¼ SW ¼ NW ¼ SW ¼	Section Number 20	Township No. T 25 S	Range Number R 29 <input type="checkbox"/> E <input checked="" type="checkbox"/> W
Street/Rural Address of Well Location; if unknown, distance & direction from nearest town or intersection: If at owner's address, check here <input type="checkbox"/> Hwy 50-400 and Rd. 10 West 10,280' North 325'		Global Positioning System (GPS) information: Latitude: (in decimal degrees) Longitude: (in decimal degrees) Elevation: Datum: <input type="checkbox"/> WGS 84, <input type="checkbox"/> NAD 83, <input type="checkbox"/> NAD 27 Collection Method: <input type="checkbox"/> GPS unit (Make/Model:) <input type="checkbox"/> Digital Map/Photo, <input type="checkbox"/> Topographic Map, <input type="checkbox"/> Land Survey Est. Accuracy: <input type="checkbox"/> <3 m, <input type="checkbox"/> 3-5 m, <input type="checkbox"/> 5-15 m, <input type="checkbox"/> >15 m		
2 WATER WELL OWNER: Julie Schmidt RR#, Street Address, Box #: 2513 N. Rouch Creek Rd. City, State, ZIP Code : Derby KS. 67037				

3 LOCATE WELL WITH AN "X" IN SECTION BOX: N  W ----- E S -----1 mile-----	4 DEPTH OF COMPLETED WELL 167 ft. Depth(s) Groundwater Encountered (1)..... ft. (2)..... ft. (3)..... ft. WELL'S STATIC WATER LEVEL 93ft. below land surface measured on mo/day/yr..... Pump test data: Well water was 104ft. after 4 hours pumping 60 gpm EST. YIELD 100gpm. Well water wasft. after hours pumping gpm Bore Hole Diameter 10in. to 167ft., andin. toft. WELL WATER TO BE USED AS: <input type="checkbox"/> Public water supply <input type="checkbox"/> Geothermal <input type="checkbox"/> Injection well <input checked="" type="checkbox"/> Domestic <input type="checkbox"/> Feedlot <input type="checkbox"/> Oil field water supply <input type="checkbox"/> Dewatering <input type="checkbox"/> Other (Specify below) <input type="checkbox"/> Irrigation <input type="checkbox"/> Industrial <input type="checkbox"/> Domestic-lawn & garden <input type="checkbox"/> Monitoring well Was a chemical/bacteriological sample submitted to Department? <input type="checkbox"/> Yes <input checked="" type="checkbox"/> No If yes, mo/day/yr sample was submitted..... Water well disinfected? <input checked="" type="checkbox"/> Yes <input type="checkbox"/> No
---	--

5 TYPE OF CASING USED: Steel PVC Other

CASING JOINTS: Glued Clamped Welded Threaded
 Casing diameter .5 in. to 137 ft., Diameter in. to ft., Diameter in. to ft.
 Casing height above land surface 18 in., Weight 200 lbs./ft., Wall thickness or gauge No. SDR21

TYPE OF SCREEN OR PERFORATION MATERIAL:
 Steel Stainless Steel PVC Other (Specify)
 Brass Galvanized Steel None used (open hole)

SCREEN OR PERFORATION OPENINGS ARE:
 Continuous slot Mill slot Gauze wrapped Torch cut Drilled holes None (open hole)
 Louvered shutter Key punched Wire wrapped Saw cut Other (specify)

SCREEN-PERFORATED INTERVALS: From 137 ft. to 167 ft., From ft. to ft.
 From ft. to ft., From ft. to ft.

GRAVEL PACK INTERVALS: From 25 ft. to 70 ft., From 90 ft. to 167 ft.
 From ft. to ft., From ft. to ft.


6 GROUT MATERIAL: Neat cement Cement grout Bentonite Other

Grout Intervals: From 5 ft. to 25 ft., From 70 ft. to 90 ft., From ft. to ft.

What is the nearest source of possible contamination:
 Septic tank Lateral lines Pit privy Livestock pens Insecticide storage Other (specify below)
 Sewer lines Cesspool Sewage lagoon Fuel storage Abandoned water well
 Watertight sewer lines Seepage pit Feedyard Fertilizer storage Oil well/gas well

Direction from well 300' Distance from well West

FROM	TO	LITHOLOGIC LOG	FROM	TO	LITHO. LOG (cont.) or PLUGGING INTERVALS
0	2	Top Soil	122	140	Light Brown Clay With Medium to
2	26	Brown Clay			Coarse Sand Streaks
26	30	Medium Sand	140	164	Medium to Coarse Sand
30	32	Blue Clay	164	167	Brown Clay
32	55	Medium to Coarse Sand			
55	61	Medium-Coarse Sand, Brown Clay Str.			
61	63	Brown Clay			
63	69	Medium to Coarse Sand			
69	99	Light Brown Clay			
99	122	Medium to Coarse Sand			

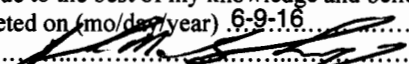7 CONTRACTOR'S OR LANDOWNER'S CERTIFICATION: This water well was constructed, reconstructed, or plugged under my jurisdiction and was completed on (mo/day/year) 6-3-16 and this record is true to the best of my knowledge and belief. Kansas Water Well Contractor's License No. 532 This Water Well Record was completed on (mo/day/year) 6-9-16 under the business name of Midwest Well & Pump Inc. by (signature) 

INSTRUCTIONS: Use typewriter or ball point pen. PLEASE PRESS FIRMLY and PRINT clearly. Please fill in blanks and check the correct answers. Send three copies (white, blue, pink) to Kansas Department of Health and Environment, Bureau of Water, Geology Section, 1000 SW Jackson St., Suite 420, Topeka, Kansas 66612-1367. Telephone 785-296-5522. Send one copy to WATER WELL OWNER and retain one for your records. Include fee of \$5.00 for each constructed well. Visit us at <http://www.kdheks.gov/waterwell/index.html>.