

MW-9

KSA 82a-1212

Check: ☒ White Copy, ☐ Blue Copy, ☐ Pink Copy

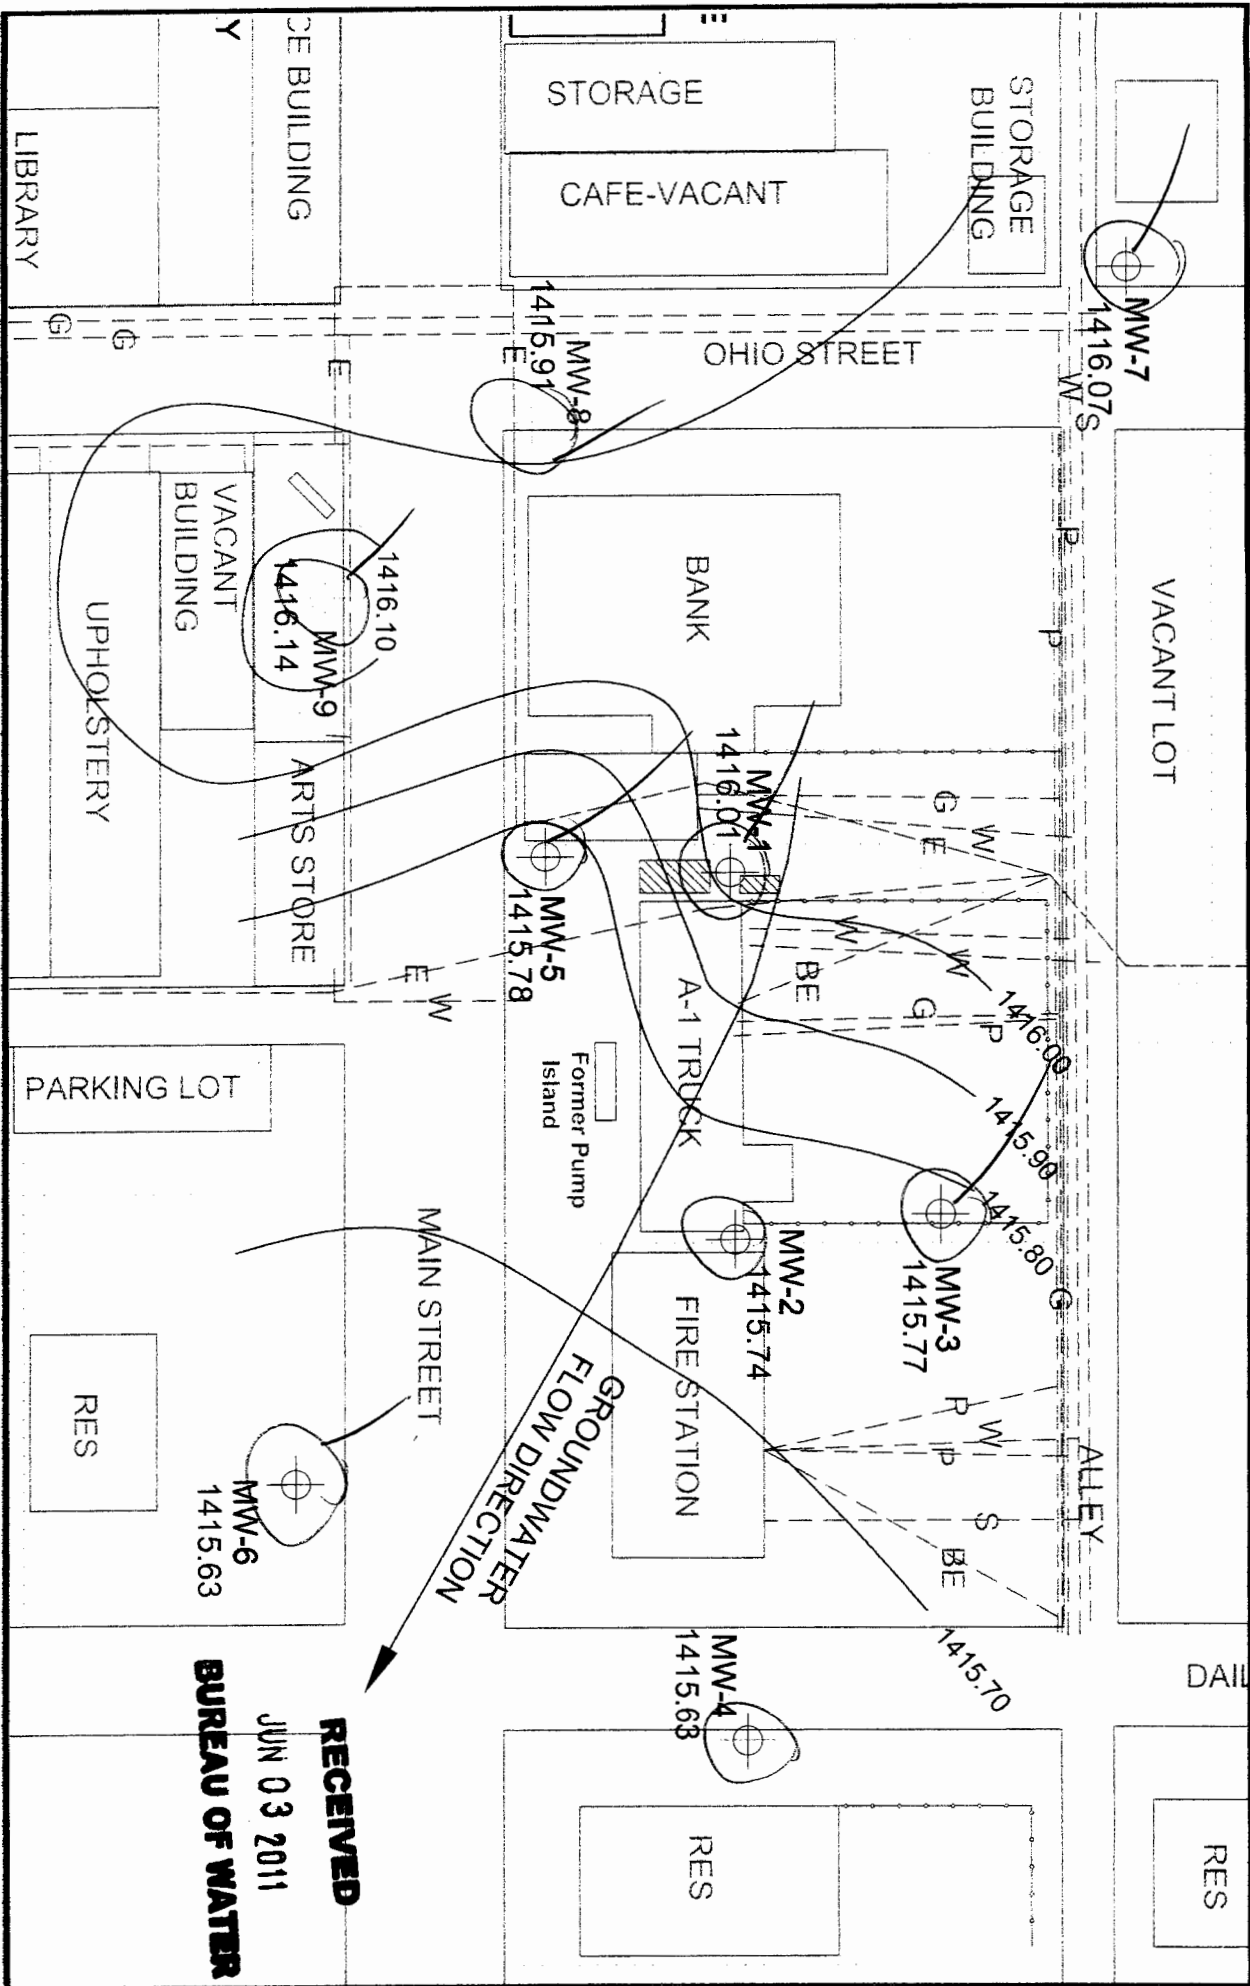


FIGURE 3 Groundwater Flow Map
KDHE Project Code: U2-087-00494

Drawn By: Barrett Stanke
Date: 11/18/10

Johnsmeyer's
110 E. Main Street
Mt. Hope, Kansas



RECEIVED
JUN 03 2011
BUREAU OF WATER