

MW-2

INSTRUCTIONS: Use typewriter or ball point pen. PLEASE PRESS FIRMLY and PRINT clearly. Please fill in blanks and check the correct answers. Send three copies (white, blue, pink) to Kansas Department of Health and Environment, Bureau of Water, Geology Section, 1000 SW Jackson St., Suite 420, Topeka, Kansas 66612-1367. Telephone 785-296-5522. Send one copy to WATER WELL OWNER and retain one for your records. Include fee of \$5.00 for each constructed well. Visit us at <http://www.kdheks.gov/waterwell/index.html>.

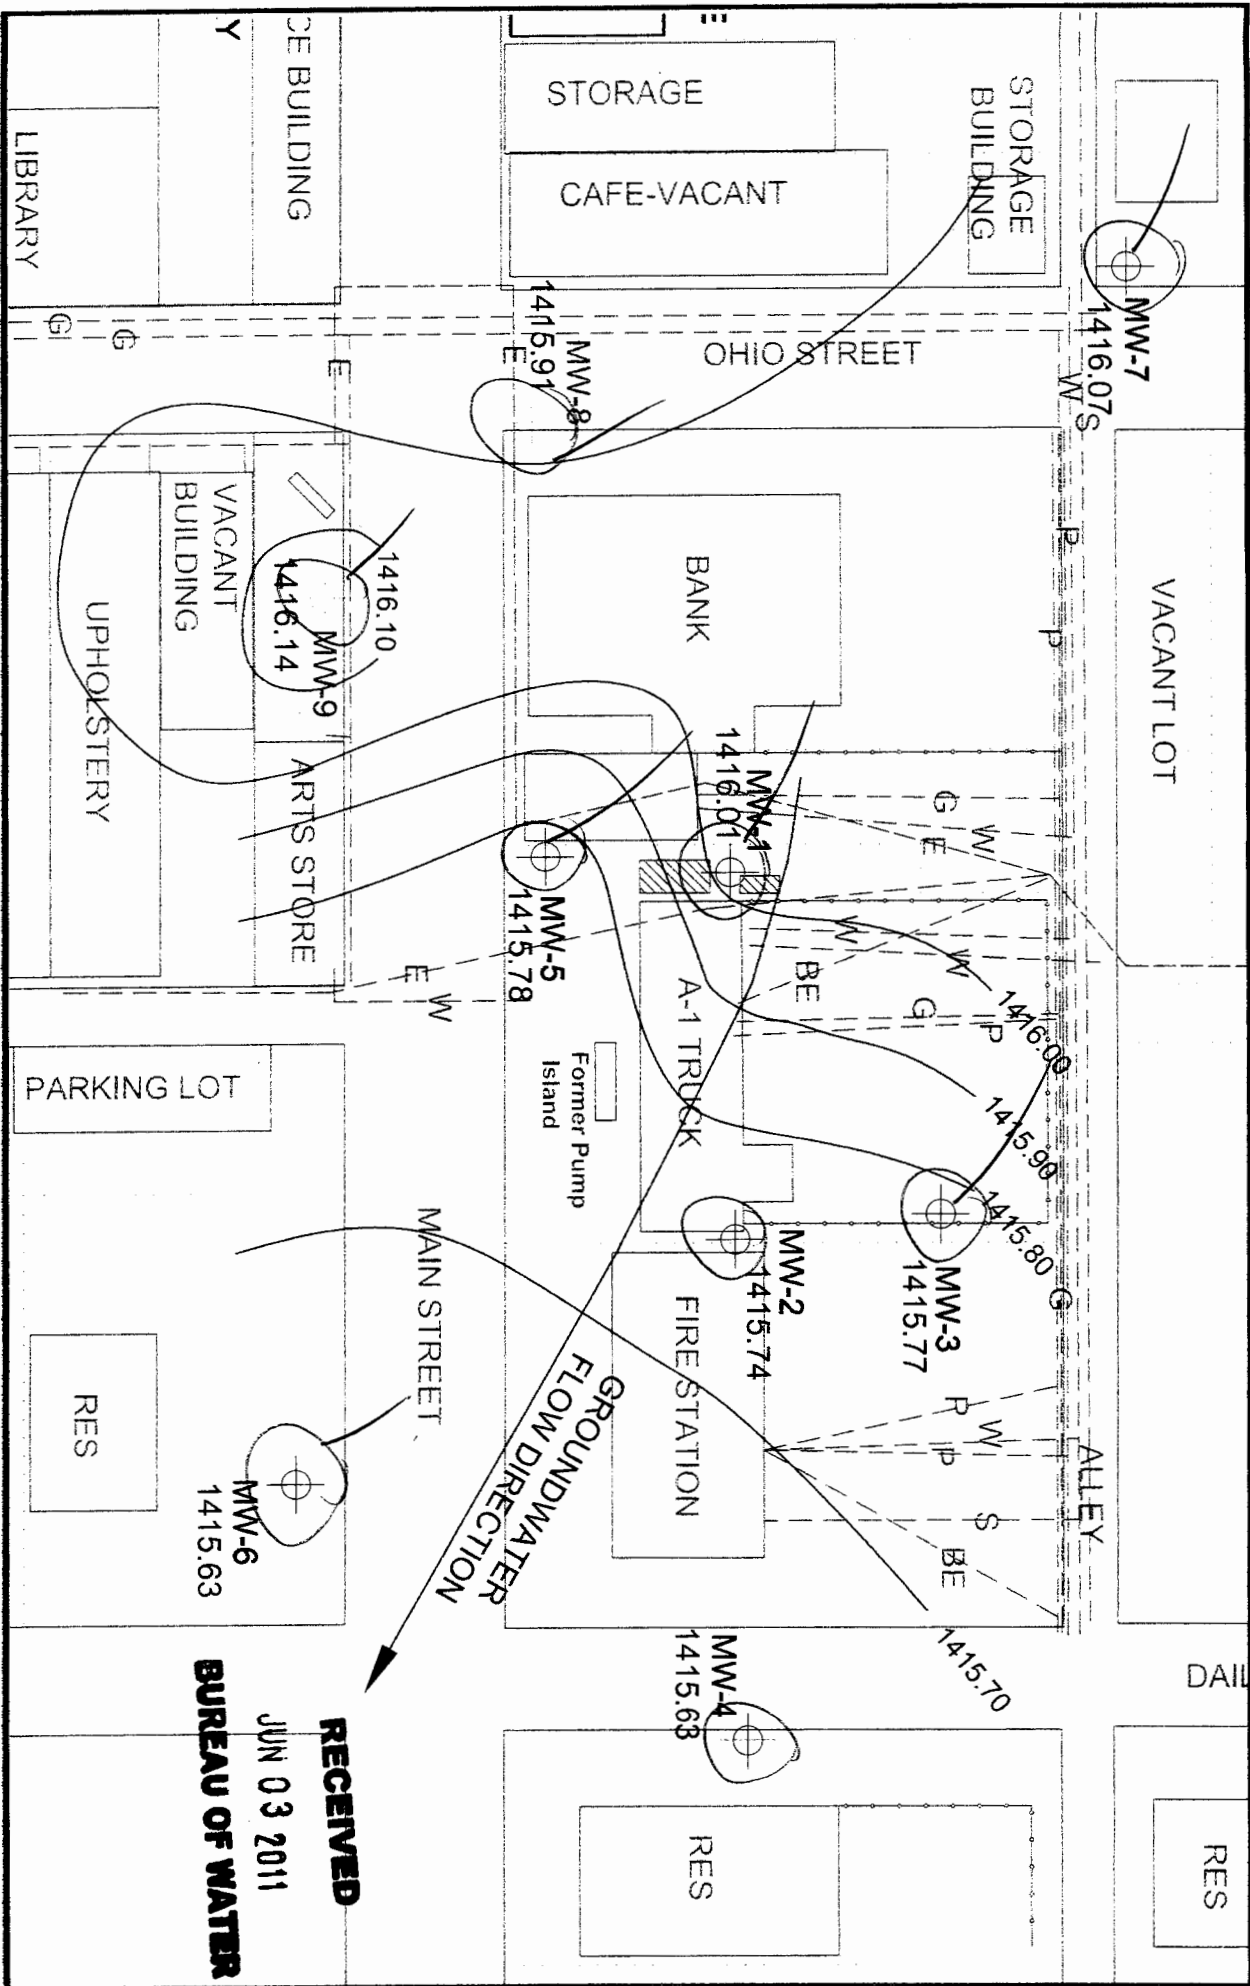


FIGURE 3 Groundwater Flow Map
 KDHE Project Code: U2-087-00494

Drawn By: Barrett Stanke
 Date: 11/18/10

Johnsmeyer's
 110 E. Main Street
 Mt. Hope, Kansas



RECEIVED
 JUN 03 2011
BUREAU OF WATER