

MW-8

Check: ☒ White Copy, ☐ Blue Copy, ☐ Pink Copy

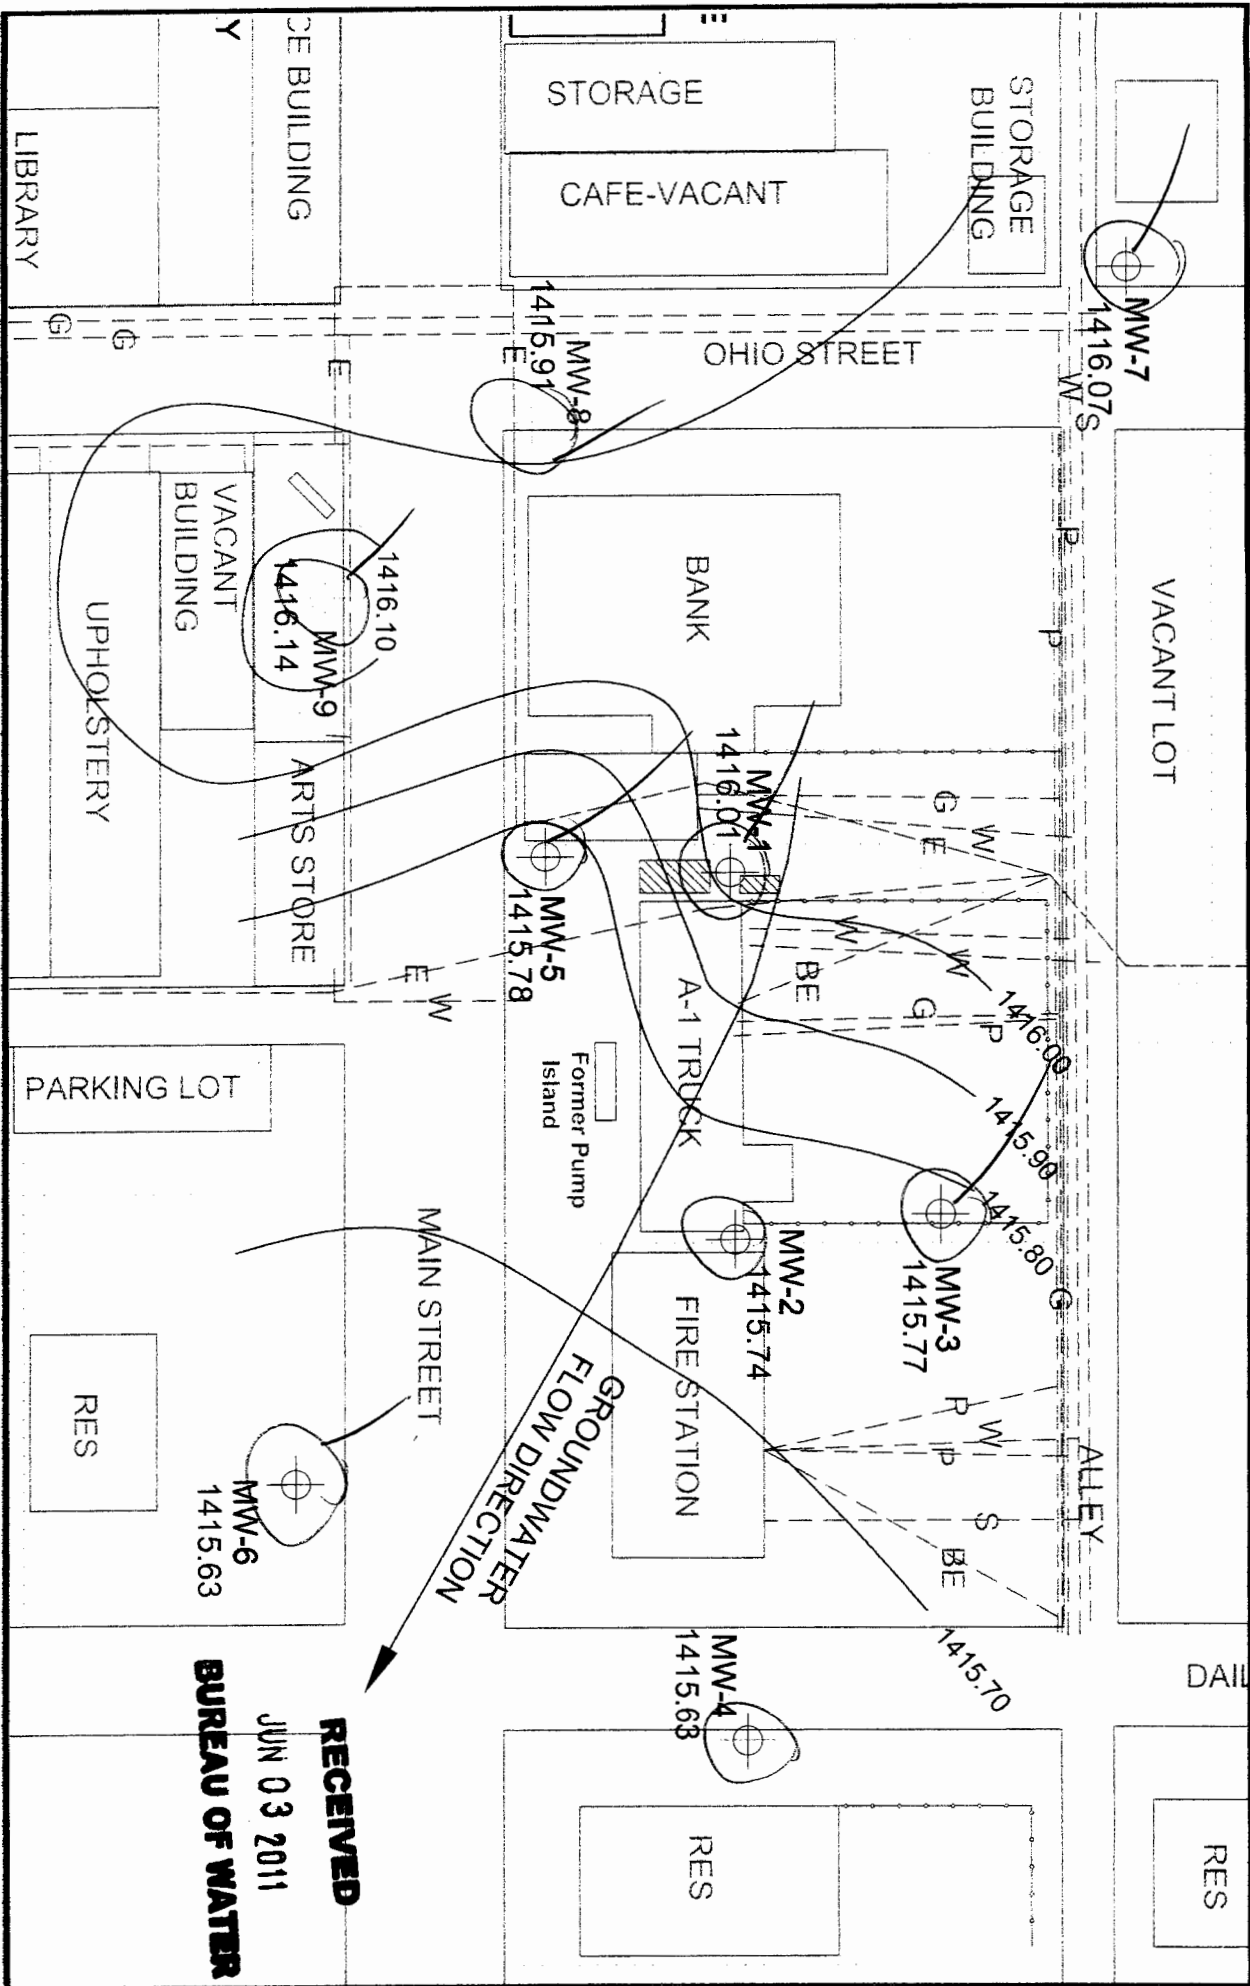


FIGURE 3 Groundwater Flow Map
 KDHE Project Code: U2-087-00494

Drawn By: Barrett Stanke
 Date: 11/18/10

Johnsmeyer's
 110 E. Main Street
 Mt. Hope, Kansas



RECEIVED
 JUN 03 2011
BUREAU OF WATER