

WATER WELL PLUGGING RECORD

Form WWC-5P

KSA 82a-1212

ID NO.

349026

1 LOCATION OF WATER WELL: County: Sedgwick	Fraction ¼ NW ¼ NE ¼ SW ¼	Section Number 15	Township Number T 25 S	Range Number 3 ☐ E ☒ W
--	------------------------------	----------------------	---------------------------	--

Street/Rural Address of Well Location; if unknown, distance & direction from nearest town or intersection: If at owner's address, check here ☒

Global Positioning Systems (GPS) information:

Latitude: _____ (in decimal degrees)
Longitude: _____ (in decimal degrees)
Elevation: _____

Datum: ☐ WGS84, ☐ NAD83, ☐ NAD27

Collection Method:


☐ GPS unit (Make/Model: _____)
☐ Digital Map/Photo, ☐ Topographic Map, ☐ Land Survey

Est. Accuracy: ☐ < 3 m, ☐ 3-5 m, ☐ 5-15 m, ☐ > 15 m

2 WATER WELL OWNER: C&J OIL COMPANY

RR#, St. Address, Box #: 25901 W. Hwy K96
City, State ZIP Code: Mt. Hope, KS 67108

3 MARK WELL'S LOCATION WITH AN "X" IN SECTION BOX:

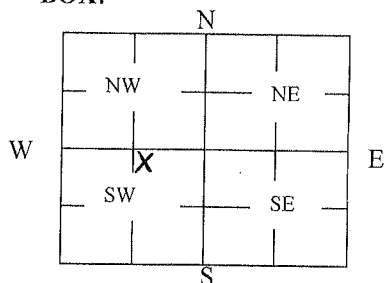

4 DEPTH OF WELL 30 ft.

WELL'S STATIC WATER LEVEL _____ ft

WELL WAS USED AS:

☐ Domestic	☐ Public Water Supply	☐ Dewatering
☐ Irrigation	☐ Oil Field Water Supply	☐ Monitoring
☐ Feedlot	☐ Domestic (Lawn & Garden)	☒ Injection Well
☐ Industrial	☐ Air Conditioning	☒ Other Air Sparge

Was a chemical/bacteriological sample submitted to Department? Yes ☐ No ☒

5 TYPE OF BLANK CASING USED:

☐ Steel ☐ RMP (SR) ☐ Wrought ☐ Fiberglass ☐ Other (Specify below)
☒ PVC ☐ ABS ☐ Asbestos-Cement ☐ Concrete Tile

Blank casing diameter 2 in. Was casing pulled? Yes ☒ No ☐ If yes, how much ~3ft. below ground surface
Casing height above or below land surface -6.72 in.

6 GROUT PLUG MATERIAL: ☐ Neat cement ☐ Cement grout ☒ Bentonite ☐ Other _____

Grout Plug Intervals: From 3 ft. to 30 ft., From _____ ft. to _____ ft., From _____ to _____ ft.

What is the nearest source of possible contamination:

☐ Septic tank	☐ Seepage pit	☐ Fuel Storage	☒ Other (specify below)
☐ Sewer lines	☐ Pit privy	☐ Fertilizer storage	Former UST Basin
☐ Watertight sewer lines	☐ Sewage lagoon	☐ Insecticide storage	
☐ Lateral lines	☐ Feedyard	☐ Abandoned water well	Direction from well? _____
☐ Cess pool	☐ Livestock pens	☐ Oil well/Gas well	How many feet? 0

FROM	TO	PLUGGING MATERIALS	FROM	TO	PLUGGING MATERIALS
3	30	Bentonite			
					AS-4

7 CONTRACTOR'S OR LANDOWNER'S CERTIFICATION: This water well was plugged under my jurisdiction and was completed on (mo/day/year) 10/17/2011 and this record is true to the best of my knowledge and belief. Kansas Water Well Contractor's License No. _____. This Water Well Record was completed on (mo/day/year) 10/25/2011 under the business name of GreenField Contractors, Inc. by (signature) Melissa D. McElwaine

INSTRUCTIONS: Use typewriter or ballpoint pen. Please press firmly and print clearly. Please fill in blanks, underline or circle the correct answers. Send top three copies to Kansas Department of Health and Environment, Bureau of Water, Geology Section, 1000 SW Jackson St., Ste. 420, Topeka, Kansas 66612-1367. Telephone: 785/296-5524. Send one to Water Well Owner and retain one for your records. Visit us at <http://www.kdheks.gov/waterwell/index.html>.

Check one: ☒ White Copy ☐ Blue Copy ☐ Pink Copy