USE TYPEWRITER OR BALL POINT PEN-PRESS FIRMLY, PRINT CLEARLY.

WATER WELL RECORD
KSA 82a-1201-1215

Kansas Department of Health and Environment-Division of Environment
(Water well Contractors)
Topeka, Kansas 66620

1. Location of well:	County	Fraction	Section number	Township number	Range number
	Sedgwick	NW 1/4 SE 1/4 SW 1/4	[redacted] 11	T 25 S	R 3 E/W (W)

2. Distance and direction from nearest town or city: 2 North of Mt Hope 2 East
Street address of well location if in city: 3450 1/4 East

3. Owner of well: Bob Hill
R.R. or street: R.R. 2
City, state, zip code: Burrton, Kansas 67020

4. Locate with "X" in section below:

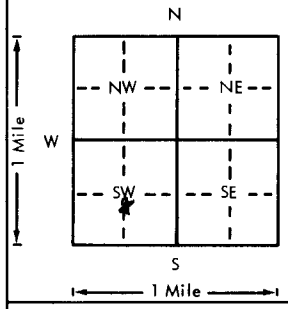

Sketch map:

6. Bore hole dia. 26 in. Completion date 6/9/79
Well depth 39 ft.

7. __ Cable tool __ Rotary __ Driven __ Dug
__ Hollow rod __ Jetted __ Bored X Reverse rotary

8. Use: __ Domestic __ Public supply __ Industry
X Irrigation __ Air conditioning __ Stock
__ Lawn __ Oil field water __ Other

9. Casing: Material Transite Weight: Above or below
Threaded ___ Welded ___ Surface 12 in.
RMP ___ PVC ___ Weight 30 lbs./ft.
Dia. 16 in. to 26 ft. depth Wall Thickness: inches or
Dia. [redacted] in. to [redacted] ft. depth gage No. 3/4

5. Type and color of material	From	To
Top soil	0	3
Clay	3	7
Sand	7	39
(Use a second sheet if needed)		

10. Screen: Manufacturer's name Johnson
Type Sawed Dia. 16
Slot/gauze 3/16 Length 13
Set between 26 ft. and 39 ft.
___ ft. and ___ ft.
Gravel pack? yes Size range of material 1/8-1/4

11. Static water level: mo./day/yr.
11 1/2 ft. below land surface Date 6/9/79

12. Pumping level below land surfaces:
19 ft. after 1 hrs. pumping 800 g.p.m.
24 ft. after 2 hrs. pumping 1100 g.p.m.
Estimated maximum yield ___ g.p.m.

13. Water sample submitted: mo./day/yr.
__ Yes X No Date ___

14. Well head completion:
__ Pitless adapter 12 Inches above grade

15. Well grouted? yes
With: ___ Neat cement ___ Bentonite X Concrete
Depth: From 0 ft. to 10 ft.

16. Nearest source of possible contamination:
ft. ___ Direction none Type ___
Well disinfected upon completion? ___ Yes X No

17. Pump: __ Not installed
Manufacturer's name Layne pump
Model number 5 stage HP 50 Volts ___
Length of drop pipe 30 ft. capacity 800 g.p.m.
Type:
___ Submersible X Turbine
___ Jet ___ Reciprocating
___ Centrifugal ___ Other

18. Elevation:

Topography:
___ Hill
/ Slope
___ Upland
___ Valley

19. Remarks:

20. Water well contractor's certification:
This well was drilled under my jurisdiction and this report is true to the best of my knowledge and belief.
Rosencrantz-Bemis Ent. INc. 134
Business name License No.
Address 1211 W. 4th, Hutchinson, Ks.
Signed Mike Howe Date 6-23
Authorized representative

T 25 — R 3 (W) m
Sec 11
1/4 NW 1/4 SE 1/4 SW 1/4

Forward the white, blue and pink copies to the Department of Health and Environment

Form WWC-5

MI-1023