USE TYPEWRITER OR BALL POINT PEN-PRESS FIRMLY, PRINT CLEARLY.

WATER WELL RECORD
KSA 82a-1201-1215

Kansas Department of Health and Environment-Division of Environment
(Water well Contractors)
Topeka, Kansas 66620

1. Location of well: County: Sedgwick Fraction: NW 1/4 NE 1/4 NW 1/4 Section number: 15 Township number: T 25 S Range number: R 3 E/W

2. Distance and direction from nearest town or city: 1 NO 1 E Mt. Hope Ks.
Street address of well location if in city:

3. Owner of well: Mike Siegel
R.R. or street:
City, state, zip code: Mt Hope, KS 67108

4. Locate with "X" in section below:

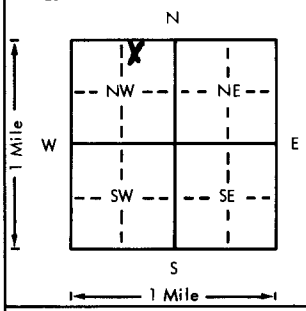

Sketch map:

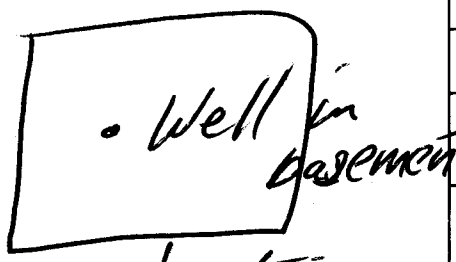

6. Bore hole dia. 11 in. Completion date 8/28/78
Well depth 65 ft.

7. __ Cable tool X Rotary __ Driven __ Dug
__ Hollow rod __ Jetted __ Bored __ Reverse rotary

8. Use: X Domestic __ Public supply __ Industry
__ Irrigation __ Air conditioning __ Stock
__ Lawn __ Oil field water __ Other

9. Casing: Material Steel Weight (Above) or below
Threaded __ Welded X Surface 12 in.
RMP __ PVC __ Weight 1.50 lb./ft.
Dia. 5 in. to 65 ft. depth Wall Thickness: inches or
Dia. __ in. to __ ft. depth gage No. 200

10. Screen: Manufacturer's name Sunflower
Type 200 Dia. 5in
Slot/gauze 146 Length 5ft
Set between 60 ft. and 65 ft.
__ ft. and __ ft.
Gravel pack yes Size range of material 38

11. Static water level:
22 ft. below land surface Date 8/28/78 mo./day/yr.

12. Pumping level below land surfaces:
28 ft. after 1/2 hrs. pumping 10 g.p.m.
__ ft. after __ hrs. pumping __ g.p.m.
Estimated maximum yield 25-40 g.p.m.

13. Water sample submitted: mo./day/yr.
__ Yes X No Date

14. Well head completion:
__ Pitless adapter 12 inches above grade

15. Well grouted? yes
With: __ Neat cement __ Bentonite X Concrete
Depth: From 6 ft. to 16 ft.

16. Nearest source of possible contamination:
ft. 100 Direction So Type Septic
Well disinfected upon completion? X Yes __ No

17. Pump: X Not installed
Manufacturer's name
Model number HP Volts
Length of drop pipe ft. capacity g.p.m.
Type:
__ Submersible __ Turbine
__ Jet __ Reciprocating
__ Centrifugal __ Other

5. Type and color of material

	From	To
Top soil	0	3
Red clay	3	20
fine sand	20	28
red clay	28	29
fine sand	29	45
gray clay	45	46
med to course gravel	46	65

(Use a second sheet if needed)

18. Elevation:

Topography:
__ Hill
__ Slope
X Upland
__ Valley

19. Remarks:

20. Water well contractor's certification:
This well was drilled under my jurisdiction and this report is true to the best of my knowledge and belief.
Wenger Drilling 318
Business name License No.
Address Colwich
Signed Authorized representative 8/28/78

Forward the white, blue and pink copies to the Department of Health and Environment

Form WWC-5

T 25 S R 3 E/W Sec 15 1/4 NW 1/4 NE 1/4 NW 1/4

MI-1023