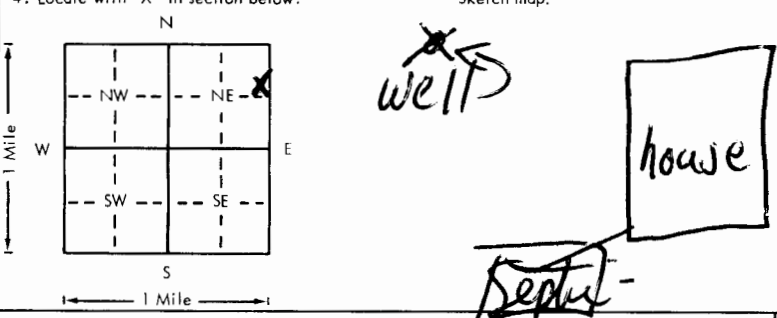


USE TYPEWRITER OR BALL
POINT PEN—PRESS FIRMLY,
PRINT CLEARLY.

WATER WELL RECORD
KSA 82a-1201-1215

Kansas Department of Health and
Environment—Division of Environment
(Water well Contractors)
Topeka, Kansas 66620

1. Location of well: County <u>Sedgwick</u> Fraction <u>SE 1/4 NE 1/4 NE 1/4</u> Section number <u>17</u> Township number <u>T 25 S R 3 W</u> Range number <u>3 W</u>	
2. Distance and direction from nearest town or city: <u>1 mile No Mt. Hope Ks.</u> Street address of well location if in city:	
3. Owner of well: <u>Heeb Boehlke</u> R.R. or street: City, state, zip code: <u>Mt. Hope Ks 67108</u>	
4. Locate with "X" in section below: Sketch map: 	
5. Type and color of material	
From To	
<u>Top soil</u> <u>0</u> <u>3</u>	
<u>Red clay</u> <u>3</u> <u>11</u>	
<u>med sand</u> <u>11</u> <u>28</u>	
<u>red clay</u> <u>28</u> <u>29</u>	
<u>course gravel</u> <u>29</u> <u>50</u>	
6. Bore hole dia. <u>11</u> in. Completion date <u>5/4/78</u> Well depth <u>50</u> ft.	
7. ☒ Cable tool ☒ Rotary ☐ Driven ☐ Dug ☐ Hollow rod ☐ Jetted ☐ Bored ☐ Reverse rotary	
8. Use: ☒ Domestic ☐ Public supply ☐ Industry ☐ Irrigation ☐ Air conditioning ☐ Stock ☐ Lawn ☐ Oil field water ☐ Other	
9. Casing: Material <u>Steel</u> Height: <u>0</u> Above or below Threading <u>Welded</u> ☒ Surface <u>1 1/2</u> in. RMP <u>X</u> PVC <u>Weight</u> <u>1.50</u> lbs./ft. Dia <u>5</u> in. to <u>50</u> ft. depth Wall Thickness: inches or Dia. <u>5</u> in. to <u>50</u> ft. depth gage No. <u>200</u>	
10. Screen: Manufacturer's name <u>Sunflower</u> Type <u>200</u> Dia. <u>5 in</u> Slot/gauze <u>1/16</u> Length <u>10 ft</u> Set between <u>40</u> ft. and <u>50</u> ft. Gravel pack? <u>Yes</u> Size range of material <u>3/8</u>	
11. Static water level: <u>12</u> ft. below land surface Date <u>5/4/78</u> mo./day/yr.	
12. Pumping level below land surfaces: <u>14</u> ft. after <u>1/2</u> hrs. pumping <u>20</u> g.p.m. <u>14</u> ft. after <u>1</u> hrs. pumping <u>20</u> g.p.m. Estimated maximum yield <u>80</u> g.p.m.	
13. Water sample submitted: <u>Yes</u> ☒ No <u>5/4/78</u> Date	
14. Well head completion: <u>Pitless adapter</u> <u>12</u> inches above grade	
15. Well grouted? <u>yes</u> With: <u>Neat cement</u> <u>Bentonite</u> ☒ Concrete Depth: From <u>3</u> ft. to <u>13</u> ft.	
16. Nearest source of possible contamination: <u>100</u> ft. Direction <u>Septic</u> Well disinfected upon completion? ☒ Yes ☐ No	
17. Pump: ☒ Not installed Manufacturer's name <u>Wenger</u> Model number <u>318</u> HP <u>1/2</u> Volts <u>115</u> Length of drop pipe <u>100</u> ft. capacity <u>20</u> g.p.m. Type: ☐ Submersible ☐ Turbine ☐ Jet ☐ Reciprocating ☐ Centrifugal ☐ Other	
18. Elevation: Topography: ☒ Hill ☐ Slope ☒ Upland ☐ Valley	
19. Remarks: <u>Customer to furnish 4x4x4" slab around casing at grade per State Regulations</u> Signed <u>Heeb Boehlke</u>	
20. Water well contractor's certification: This well was drilled under my jurisdiction and this report is true to the best of my knowledge and belief. Business name <u>Wenger</u> License No. <u>318</u> Address <u>Topeka, KS</u> Signed <u>Wenger</u> Date <u>5/4/78</u> Authorized representative	

Forward the white, blue and pink copies to the Department of Health and Environment

Form WWC-5