USE TYPEWRITER OR BALL POINT PEN-PRESS FIRMLY, PRINT CLEARLY.

T R EW sec 1/4 1/4 1/4 No.

WATER WELL RECORD
KSA 82a-1201-1215

Kansas State Dept. Of Health
(Water Well Contractors)
Forbes-Bldg. 740
Topeka, Kansas 66620

1 Location of well:	County: Sedg.	Township name: GREELEY	Fraction: SE 1/4	Section number: 18	Town number: 25S	Range number: 3W

Distance and direction from neorest town or city: 1 mile W
Street address of well location if in city: Mt Hope KS.

3 Owner of well: Jack Hefling.
Address: Mt. Hope KS

Locate with "X" in section below:

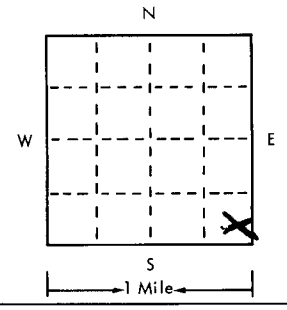

Sketch map: NEW RESIDENCE

4 Well depth: 65 ft. Date of completion 5/19
Well diameter 5 in.

5 ☐ Cable tool ☑ Rotary ☐ Driven ☐ Dug ☐ Hollow rod ☐ Jetted ☐ Bored ☐ Reverse rotary

6 Use: ☑ Domestic ☐ Public supply ☐ Industry ☐ Irrigation ☐ Air conditioning ☐ Commercial ☐ Test well ☑ ____

7 Casing: Material Plastic Height: above/below
Threaded ☐ Welded ☒ Surface 18 in.
Diam. 5 in. to 65 ft. depth Weight 160 lbs./ft 100
Drive shoe? ☐ Yes ☒ No
____ in. to ____ ft. depth

2 Type and color of material	From	To
Top Soil	0	5
Clay.	5	18
fine SAND.	18	35
COARSE GRAVEL	35	65
Customer to finish 4x4 slab on top well because he building shed over well.		

(use a second sheet if needed)

8 Screen:
Manufacturer JESCO & LOWELL
Type plastic Dia. 5 in.
Slot/gauze ____ Length 10 ft.
Set between 55 ft. and 65 ft.
Fittings:
Gravel pock ☑ Yes ☐ No Size range of material 3/8

9 Static water level:
15 ft. below land surface Date 5/19

10 Pumping level below land surfaces:
____ ft. after ____ hrs. pumping UNKNOWN g.p.m.
____ ft. after ____ hrs. pumping ____ g.p.m.
Estimated maximum yield 100 g.p.m.

11 Water sample submitted:
☐ Yes ☒ No Date ____

12 Well head completion:
☐ Pitless adapter 18 inches above grade

13 Well grouted? ☑ Yes ☐ No
☑ Neat cement ☐ Bentonite ☐ ____
Depth: From 3 ft. to 13 ft.

14 Nearest source of possible contamination:
ft. ____ Direction NONE Type ____
Well disinfected upon completion? ☒ Yes ☐ No

15 Pump: ☐ Not installed
Manufacturer's name KAILEY
Model number 18PN HP 1/2 Volts 230
Length of drop pipe 45 ft. capacity 18 g.m.p.
Type:
☑ Submersible ☐ Turbine
☐ Jet ☐ Reciprocating
☐ Certrifugal ☐ Other

16 Remarks: elevation Upland.

Topography:
☐ Hill
☐ Slope
☒ Upland
☐ Valley

17 Water well contractor's certification:
This well was drilled under my jurisdiction and this report is true to the best of my knowledge and belief.
WENINGER Well 238A
Business name License No.
Address MAIZE KS
Signed Jerome Weninger Date
Authorized representative 5/19/95

Forward the white, blue and pink copies to the Kansas State Dept. Of Health.

Form WWC-5

677-H