USE TYPEWRITER OR BALL POINT PEN-PRESS FIRMLY, PRINT CLEARLY.

T R EW sec 1/4 1/4 1/4 No.

WATER WELL RECORD
KSA 82a-1201-1215

Kansas State Dept. Of Health
(Water Well Contractors)
Forbes-Bldg. 740
Topeka, Kansas 66620

1 Location of well:	County	Township name	Fraction	Section number	Town number	Range number
	Sedgwick	Greely	NW¼ NW¼ NE¼	30	25S	3W

Distance and direction from nearest town or city: 15, 1½ W. of Mount Hope

Street address of well location if in city:

3 Owner of well: Steve Beal

Address: Mt. Hope, Kansas

Locate with "X" in section below:

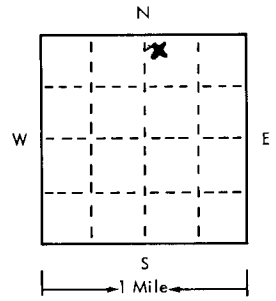

Sketch map:

4 Well depth: 67 ft. Date of completion 4/3/96
Well diameter 30 in.

5 ☐ Cable tool ☐ Rotary ☐ Driven ☐ Dug ☐ Hollow rod ☐ Jetted ☐ Bored ☒ Reverse rotary

6 Use: ☐ Domestic ☐ Public supply ☐ Industry ☒ Irrigation ☐ Air conditioning ☐ Commercial ☐ Test well ☐ _____

7 Casing: Material C-Asb Height: above/below
Threaded ☐ Welded ☐ Surface 8 in.
Diam. 16 in. to 67 ft. depth Weight ____ lbs./ft.
____ in. to ____ ft. depth Drive shoe? ☐ Yes ☒ No

2 Type and color of material	From	To
Topsoil	0	1
Fine Sand	1	25
Clay + Sand	25	45
Good Gravel - med.	45	67
(use a second sheet if needed)		

8 Screen:
Manufacturer Johnson
Type Cem-Asb. Dia. 16"
Slot/gauze 1/4" Length 13'
Set between 54 ft. and 67 ft.
Fittings:
Gravel pack ☒ Yes ☐ No Size range of material 3/8

9 Static water level:
41 ft. below land surface Date 4/3

10 Pumping level below land surfaces:
55 ft. after 2 hrs. pumping 750 g.p.m.
____ ft. after ____ hrs. pumping ____ g.p.m.
Estimated maximum yield 800 g.p.m.

11 Water sample submitted:
☐ Yes ☒ No Date ____

12 Well head completion:
☐ Pitless adapter ☒ Inches above grade

13 Well grouted? ☒ Yes ☐ No
☒ Neat cement ☐ Bentonite ☐ _____
Depth: From 0 ft. to 10 ft.

14 Nearest source of possible contamination:
ft. 400 Direction NE Type Domestic
Well disinfected upon completion? ☐ Yes ☒ No

15 Pump: ☐ Not installed
Manufacturer's name Peerless
Model number 5854 HP 40 Volts ____
Length of drop pipe 60 ft. capacity 800 g.m.p.
Type:
☐ Submersible ☒ Turbine
☐ Jet ☐ Reciprocating
☐ Centrifugal ☐ Other

16 Remarks: elevation

Topography:
☐ Hill
☐ Slope
☒ Upland
☐ Valley

17 Water well contractor's certification:
This well was drilled under my jurisdiction and this report is true to the best of my knowledge and belief.
Weninger Drilling 238
Business name License No.
Address Maize, Kansas 67101
Signed K. Weninger Date 4/5/96
Authorized representative

Forward the white, blue and pink copies to the Kansas State Dept. Of Health.

Form WWC-5

677-H

25-3W-30
NW-NW-NE