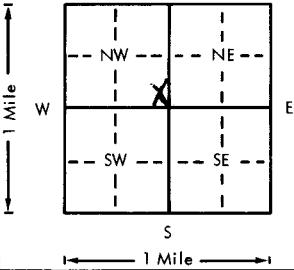
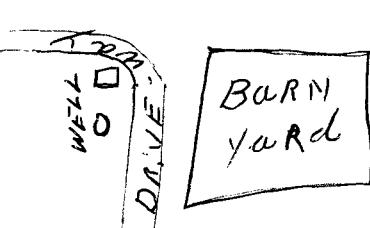


USE TYPEWRITER OR BALL
POINT PEN-PRESS FIRMLY,
PRINT CLEARLY.

WATER WELL RECORD
KSA 82a-1201-1215

Kansas Department of Health and
Environment-Division of Environment
(Water well Contractors)
Topeka, Kansas 66620

1. Location of well:	County Gray	Fraction SE 1/4 SE 1/4 NW 1/4	Section number 24	Township number T 25	Range number S R 30 E <input checked="" type="checkbox"/>	
2. Distance and direction from nearest town or city:	in Charleston, Ks		3. Owner of well:	Don Renick		
Street address of well location if in city:			R.R. or street:	City, state, zip code: Ingalls, Kansas 67853		
4. Locate with "X" in section below:			Sketch map:	6. Bore hole dia. <u>8</u> in. Completion date <u>6-1-77</u> Well depth <u>125</u> ft.		
				7. <input checked="" type="checkbox"/> Cable tool <input checked="" type="checkbox"/> Rotary <input type="checkbox"/> Driven <input type="checkbox"/> Dug <input type="checkbox"/> Hollow rod <input type="checkbox"/> Jetted <input type="checkbox"/> Bored <input type="checkbox"/> Reverse rotary		
				8. Use: <input type="checkbox"/> Domestic <input type="checkbox"/> Public supply <input type="checkbox"/> Industry <input type="checkbox"/> Irrigation <input type="checkbox"/> Air conditioning <input checked="" type="checkbox"/> Stock <input type="checkbox"/> Lawn <input type="checkbox"/> Oil field water <input type="checkbox"/> Other		
				9. Casing: Material <u>RMP</u> Height: Above or below <u>XXIX</u> Threaded <input type="checkbox"/> Welded <input type="checkbox"/> Surface <u>20</u> in. RMP <u>XX</u> PVC <input type="checkbox"/> Weight <input type="checkbox"/> lbs./ft. Dia. <u>5</u> in. to <u>125</u> ft. depth Wall Thickness: inches or Dia. <input type="checkbox"/> in. to <input type="checkbox"/> ft. depth gage No. <u>250</u>		
5. Type and color of material			From	To	10. Screen: Manufacturer's name <u>sunflower</u> Type <u>RMP</u> Dia. <u>5"</u> Slot/gauge <u>1/8"</u> Length <u>20</u> ft. Set between <u>100</u> ft. and <u>120</u> ft. ft. and <input type="checkbox"/> ft. Gravel pack? <input checked="" type="checkbox"/> yes Size range of material <u>5"</u>	
Topsoil, coarse sand & sand rock layers			0	15	11. Static water level: <u>40</u> ft. below land surface Date <u>6-1-77</u> mo./day/yr.	
Coarse sand & clay			15	30	12. Pumping level below land surfaces: None <input type="checkbox"/> ft. after <input type="checkbox"/> hrs. pumping <input type="checkbox"/> g.p.m. <input type="checkbox"/> ft. after <input type="checkbox"/> hrs. pumping <input type="checkbox"/> g.p.m. Estimated maximum yield <input type="checkbox"/> g.p.m.	
Coarse sand & clay layers			30	45	13. Water sample submitted: <input type="checkbox"/> Yes <input checked="" type="checkbox"/> No Date <input type="checkbox"/>	
" " " "			45	60	14. Well head completion: <input checked="" type="checkbox"/> None <input type="checkbox"/> Pitless adapter <input type="checkbox"/> Inches above grade	
Coarse sand, cleechy and clay layers			60	75	15. Well grouted? <input checked="" type="checkbox"/> yes With: <input type="checkbox"/> Neat cement <input checked="" type="checkbox"/> Bentonite <input type="checkbox"/> Concrete Depth: From <u>0</u> ft. to <u>15</u> ft.	
Clay, cleechy & ^{sand rock} clay layers and coarse sand			75	90	16. Nearest source of possible contamination: <input checked="" type="checkbox"/> None ft. <input type="checkbox"/> Direction <input type="checkbox"/> Type <input type="checkbox"/> Well disinfected upon completion? <input checked="" type="checkbox"/> Yes <input type="checkbox"/> No	
Clay layers & coarse sand			90	105	17. Pump: <input checked="" type="checkbox"/> Windmill <input type="checkbox"/> Not installed Manufacturer's name <input type="checkbox"/> Model number <input type="checkbox"/> HP <input type="checkbox"/> Volts <input type="checkbox"/> Length of drop pipe <input type="checkbox"/> ft. capacity <input type="checkbox"/> g.p.m. Type: <input type="checkbox"/> Submersible <input type="checkbox"/> Turbine <input type="checkbox"/> Jet <input type="checkbox"/> Reciprocating <input type="checkbox"/> Centrifugal <input type="checkbox"/> Other	
Coarse sand & clay layers			105	120		
Coarse sand & clay			120	135		
Clay			135	140		
(Use a second sheet if needed)						
18. Elevation:	19. Remarks: drains South and East					20. Water well contractor's certification: This well was drilled under my jurisdiction and this report is true to the best of my knowledge and belief. Joe's Well Service <u>179</u> Business name <input type="checkbox"/> Address <u>Box 174 Cimarron, Ks.</u> License No. <input type="checkbox"/> Signed <u>Tony Clark</u> Date <u>6-24-77</u> Authorized representative <input type="checkbox"/>
Topography: <input type="checkbox"/> Hill <input checked="" type="checkbox"/> Slope <input type="checkbox"/> Upland <input type="checkbox"/> Valley						