

WATER WELL RECORD

Form WWC-5

KSA 82a-1212

1 LOCATION OF WATER WELL:		Fraction County: GRAY	NE $\frac{1}{4}$	SW $\frac{1}{4}$	Section Number 27	T 25	S	Range Number R 35	EW
---------------------------	--	---------------------------------	------------------	------------------	----------------------	------	---	----------------------	----

Distance and direction from nearest town or city street address of well if located within city?

3 MILE SOUTH CHARLESTON 2 MILE WEST

2 WATER WELL OWNER:		LENORA WARTHAN PIERCEVILLE, KS.		Board of Agriculture, Division of Water Resources Application Number:				
---------------------	--	--	--	--	--	--	--	--

3 LOCATE WELL'S LOCATION WITH AN "X" IN SECTION BOX:		4 DEPTH OF COMPLETED WELL..... 142 ft. ELEVATION:	
--	--	--	--

Depth(s) Groundwater Encountered 1..... ft. 2..... ft. 3..... ft.

WELL'S STATIC WATER LEVEL **32** ft. below land surface measured on mo/day/yr **5/81**

Pump test data: Well water was ft. after hours pumping gpm

Est. Yield gpm: Well water was ft. after hours pumping gpm

Bore Hole Diameter **7/8** in. **678** ft. and in. to ft.

WELL WATER TO BE USED AS: 5 Public water supply 8 Air conditioning 11 Injection well

1 Domestic 3 Feedlot 6 Oil field water supply 9 Dewatering 12 Other (Specify below)

2 Irrigation 4 Industrial 7 Lawn and garden only 10 Monitoring well

Was a chemical/bacteriological sample submitted to Department? Yes..... No..... If yes, mo/day/yr sample was submitted

Water Well Disinfected? Yes No

5 TYPE OF BLANK CASING USED: 5 Wrought iron 8 Concrete tile CASING JOINTS: Glued Clamped

1 Steel 3 RMP (SR) 6 Asbestos-Cement 9 Other (specify below) Welded

2 PVC 4 ABS 7 Fiberglass Threaded

Blank casing diameter in. to **122** ft. Dia in. to ft. Dia in. to ft.Casing height above land surface in., weight **255** lbs./ft. Wall thickness or gauge No.6 TYPE OF SCREEN OR PERFORATION MATERIAL: **x7** PVC 10 Asbestos-cement

1 Steel 3 Stainless steel 5 Fiberglass 8 RMP (SR) 11 Other (specify)

2 Brass 4 Galvanized steel 6 Concrete tile 9 ABS 12 None used (open hole)

SCREEN OR PERFORATION OPENINGS ARE: 5 Gauzed wrapped 8 Saw cut 11 None (open hole)

1 Continuous slot **x3** Mill slot 6 Wire wrapped 9 Drilled holes

2 Louvered shutter 4 Key punched 7 Torch cut 10 Other (specify)

SCREEN-PERFORATED INTERVALS: From **122** ft. to **142** ft. From ft. to ft.

From ft. to ft. From ft. to ft.

GRAVEL PACK INTERVALS: From **155** ft. to **142** ft. From ft. to ft.

From ft. to ft. From ft. to ft.

6 GROUT MATERIAL: 1 Neat cement 2 Cement grout 3 Bentonite 4 Other

Grout Intervals: From ft. to ft., From ft. to ft., From ft. to ft.

What is the nearest source of possible contamination: 10 Livestock pens 14 Abandoned water well

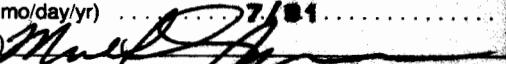
x1 Septic tank 4 Lateral lines 7 Pit privy 11 Fuel storage 15 Oil well/Gas well

2 Sewer lines 5 Cess pool 8 Sewage lagoon 12 Fertilizer storage 16 Other (specify below)

3 Watertight sewer lines 6 Seepage pit 9 Feedyard 13 Insecticide storage

Direction from well? How many feet? **155**

FROM TO DEPTH LITHOLOGIC LOG FROM TO PLUGGING INTERVALS

5 **35** **FINE SAND AND GRAVEL****35** **55** **BROWN SANDY CLAY****55** **75** **FINE TO MED SAND AND GRAVEL****75** **107** **BROWN SANDY CLAY****107** **113** **FINE TO MED SAND AND GRAVEL****113** **125** **BROWN SANDY CLAY****125** **131** **FINE TO MED SAND AND GRAVEL****131** **170** **BROWN SANDY CLAY**7 CONTRACTOR'S OR LANDOWNER'S CERTIFICATION: This water well was (1) constructed, (2) reconstructed, or (3) plugged under my jurisdiction and was completed on (mo/day/year) **7/81**..... and this record is true to the best of my knowledge and belief. KansasWater Well Contractor's License No. **172**..... This Water Well Record was completed on (mo/day/yr) **7/81**..... by (signature) 

INSTRUCTIONS: Use typewriter or ball point pen. PLEASE PRESS FIRMLY and PRINT clearly. Please fill in blanks, underline or circle the correct answers. Send top copy to Kansas Department of Health and Environment, Bureau of Water, Topeka, Kansas 66620-7320. Telephone: 913-296-5545. Send one to WATER WELL OWNER and retain one for your records.