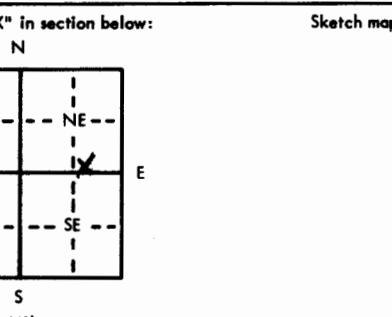


USE TYPEWRITER OR BALL
POINT PEN-PRESS FIRMLY,
PRINT CLEARLY.

WATER WELL RECORD
KSA 82a-1201-1215

Kansas Department of Health and
Environment-Division of Environment
(Water well Contractors)
Topeka, Kansas 66620

1. Location of well:	County: Gray	Fraction: SW 1/4 SE 1/4 NE 1/4	Section number: 33	Township number: T 25	Range number: S 30	EW
2. Distance and direction from nearest town or city: Street address of well location if in city:	4 south, 2 3/4 east, 3/4 north of Pierceville.		3. Owner of well: R.R. or street: City, state, zip code:	Wartman Ranch % Jack Wartman Pierceville, Ks. 67868		
4. Locate with "X" in section below:	Sketch map: 		6. Bore hole dia. <u>26</u> in. Completion date <u>5-18-77</u> Well depth <u>218</u> ft.			
			7. <input type="checkbox"/> Cable tool <input type="checkbox"/> Rotary <input type="checkbox"/> Driven <input type="checkbox"/> Dug <input type="checkbox"/> Hollow rod <input type="checkbox"/> Jetted <input type="checkbox"/> Bored <input checked="" type="checkbox"/> Reverse rotary			
			8. Use: <input type="checkbox"/> Domestic <input type="checkbox"/> Public supply <input type="checkbox"/> Industry <input checked="" type="checkbox"/> Irrigation <input type="checkbox"/> Air conditioning <input type="checkbox"/> Stock <input type="checkbox"/> Lawn <input type="checkbox"/> Oil field water <input type="checkbox"/> Other			
			9. Casing: Material <u>steel</u> Height: Above bottom <u>0</u> in. Threaded <input type="checkbox"/> Welded <input checked="" type="checkbox"/> Surface <u>12</u> in. RMP <u>0</u> PVC <u>0</u> Weight <u>36.87</u> lbs./ft. Dia. <u>16</u> in. to <u>219</u> ft. depth; Wall thickness: inches or Dia. <u>0</u> in. to <u>0</u> ft. depth gage No. <u>250</u>			
5. Type and color of material	From	To	10. Screen: Manufacturer's name <u>Johnson</u> Type <u>galv.</u> Dia. <u>16"</u> Slot <u>0.0625</u> in. Length <u>10 ft.</u> Set between <u>170-180</u> ft. and <u>200-210</u> ft. Perf: <u>70-170</u> ft. and <u>180-200, 210-218</u> ft. Gravel pack? <u>yes</u> Size range of material <u>2"</u> down			
			11. Static water level: <u>30</u> ft. below land surface Date <u>4-28-77</u> mo./day/yr.			
			12. Pumping level below land surfaces: <u>55</u> ft. after <u>2</u> hrs. pumping <u>900</u> g.p.m. <u>76</u> ft. after <u>4</u> hrs. pumping <u>1600</u> g.p.m. Estimated maximum yield <u>1600</u> g.p.m.			
			13. Water sample submitted: <u>no</u> mo./day/yr. Yes <input checked="" type="checkbox"/> No <input type="checkbox"/> Date			
			14. Well head completion: Pitless adapter <u>12</u> inches above grade			
			15. Well grouted? <u>yes</u> With: <input type="checkbox"/> Neat cement <input type="checkbox"/> Bentonite <input checked="" type="checkbox"/> Concrete Depth: From <u>0</u> ft. to <u>10</u> ft.			
			16. Nearest source of possible contamination: <u>N/A</u> ft. <u>0</u> Direction <u>0</u> Type <u>0</u> Well disinfected upon completion? <u>no</u> Yes <input checked="" type="checkbox"/> No			
			17. Pump: Not installed Manufacturer's name <u>Goulds - US Pump</u> Model number <u>12JMO</u> HP <u>0.5</u> Volts <u>115</u> Length of drop pipe <u>140</u> ft. capacity <u>1200</u> g.p.m. Type: <input type="checkbox"/> Submersible <input checked="" type="checkbox"/> Turbine <input type="checkbox"/> Jet <input type="checkbox"/> Reciprocating <input type="checkbox"/> Centrifugal <input type="checkbox"/> Other			
18. Elevation: Topography: <input type="checkbox"/> Hill <input checked="" type="checkbox"/> Slope <input type="checkbox"/> Upland <input type="checkbox"/> Valley			19. Remarks: Customer furnished the motor. (Use a second sheet if needed)			
			20. Water well contractor's certification: This well was drilled under my jurisdiction and this report is true to the best of my knowledge and belief. Minter-Wilson Drilling Co. <u>208</u> Business name <u>Box A Garden City, Ks.</u> License No. Address <u>7-25</u> Signature <u>John Minter</u> Date <u>7-25-77</u> Authorized representative <u>John Minter</u>			

Forward the white, blue and pink copies to the Department of Health and Environment

Form WWC-5

*By
Professionals*

MINTER-WILSON DRILLING CO.

INCORPORATED

Irrigation
and Domestic
Water Systems
Complete Installation
and Repairing

Phone 276-8269 • P.O. Box A • GARDEN CITY, KANSAS 67846

WARTMAN BROS,
GRAY COUNTY
3/1/77

Location: NE 33-25-30 Pivot
Static Water Level- 35'

Test #2

0	4	Fine sand
4	14	Brown clay
14	89	Fine to med. sand and gravel
89	97	Brownclay
97	110	Fine to med. sand and gravel
110	141	Brown clay
141	181	Fine to med. sand and gravel
181	202	Brown clay
202	216	Fine to med. sand and gravel
216	218	Yellow clay
218	222	Shale