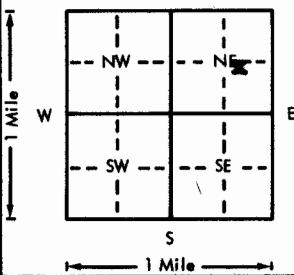
 
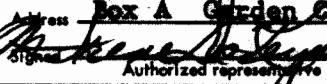


USE TYPEWRITER OR BALL
POINT PEN-PRESS FIRMLY,
PRINT CLEARLY.

WATER WELL RECORD
KSA 82a-1201-1215

Kansas Department of Health and
Environment-Division of Environment
(Water well Contractors)
Topeka, Kansas 66620

1. Location of well:	County Gray	Fraction NW 1/4 SE 1/4 NE 1/4	Section number 36	T 25 S	R 30 E	Range number EW	
2. Distance and direction from nearest town or city: Street address of well location if in city:	1/2 south of the Charleston bridge, 1/2 east, 1/2 south.		3. Owner of well: R.R. or street: City, state, zip code:	Don Renick (#63) Ingalls, Ks. 67853			
4. Locate with "X" in section below:	Sketch map: 		6. Bore hole dia. 26 in. Completion date 2-25-77 Well depth 206 ft.				
5. Type and color of material	From	To	7. <input type="checkbox"/> Cable tool <input type="checkbox"/> Rotary <input type="checkbox"/> Driven <input type="checkbox"/> Dug <input type="checkbox"/> Hollow rod <input type="checkbox"/> Jetted <input type="checkbox"/> Bored <input checked="" type="checkbox"/> Reverse rotary				
			8. Use: <input type="checkbox"/> Domestic <input type="checkbox"/> Public supply <input type="checkbox"/> Industry <input checked="" type="checkbox"/> Irrigation <input type="checkbox"/> Air conditioning <input type="checkbox"/> Stock <input type="checkbox"/> Lawn <input type="checkbox"/> Oil field water <input type="checkbox"/> Other				
			9. Casing: Material <input type="checkbox"/> steel <input checked="" type="checkbox"/> iron Height: Above bottom Threaded <input type="checkbox"/> Welded <input checked="" type="checkbox"/> Surface 12 in. RMP <input type="checkbox"/> PVC <input type="checkbox"/> Weight 36.87 lbs./ft. Dia. 16 in. to 207 ft. depth Wall Thickness: inches or Dia. <input type="checkbox"/> in. to <input type="checkbox"/> ft. depth gage No. 250				
			10. Screen: Manufacturer's name Johnson Type galva. Dia. 16" <input type="checkbox"/> Slot <input type="checkbox"/> Length 20 ft. Set between 180 ft. and 200 ft. Perf: 90-180 ft. and 200-206 ft. Gravel pack? <input checked="" type="checkbox"/> Yes Size range of material 1" down				
			11. Static water level: mo./day/yr. 47 ft. below land surface Date 2-22-77				
			12. Pumping level below land surfaces: 61 ft. after 2 hrs. pumping 900 g.p.m. 74 ft. after 4 hrs. pumping 1500 g.p.m. Estimated maximum yield 1500 g.p.m.				
			13. Water sample submitted: mo./day/yr. Yes <input checked="" type="checkbox"/> No Date				
			14. Well head completion: <input type="checkbox"/> Pitless adapter 12 inches above grade				
			15. Well grouted? <input checked="" type="checkbox"/> Yes With: <input type="checkbox"/> Neat cement <input type="checkbox"/> Bentonite <input checked="" type="checkbox"/> Concrete Depth: From 0 ft. to 10 ft.				
			16. Nearest source of possible contamination: N/A ft. <input type="checkbox"/> Direction <input type="checkbox"/> Type <input type="checkbox"/> Well disinfected upon completion? Yes <input checked="" type="checkbox"/> No				
			17. Pump: Not installed Manufacturer's name Customer's Model number <input type="checkbox"/> HP <input type="checkbox"/> Volts <input type="checkbox"/> Length of drop pipe <input type="checkbox"/> ft. capacity <input type="checkbox"/> g.p.m. Type: <input type="checkbox"/> Submersible <input type="checkbox"/> Turbine <input type="checkbox"/> Jet <input type="checkbox"/> Reciprocating <input type="checkbox"/> Centrifugal <input type="checkbox"/> Other				
(Use a second sheet if needed)			18. Elevation: Topography: <input type="checkbox"/> Hill <input checked="" type="checkbox"/> Slope <input type="checkbox"/> Upland <input type="checkbox"/> Valley				
			19. Remarks: 				
			20. Water well contractor's certification: This well was drilled under my jurisdiction and this report is true to the best of my knowledge and belief. Minter-Wilson Drilling Co. 208 Business name <input type="checkbox"/> License No. Address Box A Garden City, Ks. Signed  Date 11-28-77 Authorized representative				

• The
Professionals

MINTER-WILSON DRILLING CO.

INCORPORATED

Irrigation
and Domestic
Water Systems
Complete Installation
and Repairing

Phone 376-8269

P.O. Box A

GARDEN CITY, KANSAS 67846

DON RENICK
GRAY COUNTY
1/ 26/77

Location: NE 36-25-30 south of Charleston 2½ miles
and ½ east 30 Ft. west of pivot

Static Water Level- 60

Test #1

0	10	Top soil fine sand
10	19	Med. course gravel
19	66	Brown sandy clay
66	80	Fine to med. sand and gravel
80	112	Fine to med. sand and gravel Good Loose
112	119	Fine to med. sand and gravel 10% clay Loose
119	142	Fine to med. sand and gravel Loose
142	153	Brown sandy clay
153	164	Fine to med. sand Loose
164	185	Fine to med. sand and gravel Good Loose
185	206	Med. sand to med. course gravel mixed yellow brown rock
206	212	Yellow clay
212	214	Shale

T.D. 206

1 - Copy of log