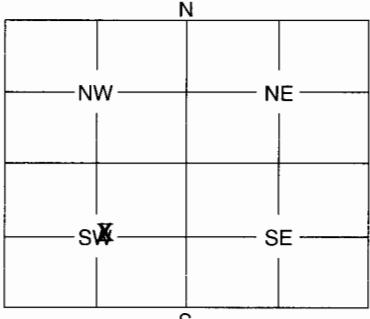


1	LOCATION OF WATER WELL: Finney	Fraction Near Center $\frac{1}{4}$ $\frac{1}{4}$ SW $\frac{1}{4}$	Section Number 24	Township Number 25	Range Number 31
---	--	--	-----------------------------	------------------------------	---------------------------

Distance and direction from nearest town or city street address of well if located within city?

From Bridge just south of Pierceville - 1 mile south, 1 mile east, 1,320 ft. n. 3,950 ft. W.

2	WATER WELL OWNER: Nelle Beach Trust c/o Mel Crist	
	RR #, St. Address, Box #: 811 N. Main St.	Board of Agriculture, Division of Water Resources
	City, State, ZIP Code: Garden City, Kansas 67846	Application Number: 25,969

3	MARK WELL'S LOCATION WITH AN "X" IN SECTION BOX: 	4	DEPTH OF WELL 180 ft. WELL'S STATIC WATER LEVEL 55 ft. WELL WAS USED AS: <table border="0"> <tr> <td>1 Domestic</td> <td>5 Public Water Supply</td> <td>9 Dewatering</td> </tr> <tr> <td>2 Irrigation</td> <td>6 Oil Field Water Supply</td> <td>10 Monitoring Well</td> </tr> <tr> <td>3 Feedlot</td> <td>7 Domestic (Lawn & Garden)</td> <td>11 Injection Well</td> </tr> <tr> <td>4 Industrial</td> <td>8 Air Conditioning</td> <td>12 Other</td> </tr> </table> Was a chemical / bacteriological sample submitted to Department? Yes No X If yes, mo/day/yr sample was submitted Water Well Disinfected: Yes X No	1 Domestic	5 Public Water Supply	9 Dewatering	2 Irrigation	6 Oil Field Water Supply	10 Monitoring Well	3 Feedlot	7 Domestic (Lawn & Garden)	11 Injection Well	4 Industrial	8 Air Conditioning	12 Other
1 Domestic	5 Public Water Supply	9 Dewatering													
2 Irrigation	6 Oil Field Water Supply	10 Monitoring Well													
3 Feedlot	7 Domestic (Lawn & Garden)	11 Injection Well													
4 Industrial	8 Air Conditioning	12 Other													

5	TYPE OF BLANK CASING USED:	
	1 Steel 2 PVC 3 RMP (SR) 4 ABS 5 Wrought 6 Asbestos-Cement 7 Fiberglass 8 Concrete Tile 9 Other (Specify below)	
	Blank casing diameter 16 in.	Was casing pulled? Yes No X
	Casing height above or below land surface 36 in.	If yes, how much

6	GROUT PLUG MATERIAL: 1 Neat cement 2 Cement grout 3 Bentonite 4 Other	
	Grout Plug Intervals: From 3 ft. to 55 ft., From ft. to ft., From to ft.	
	What is the nearest source of possible contamination:	
	1 Septic tank 2 Sewer lines 3 Watertight sewer lines 4 Lateral lines 5 Cess pool 6 Seepage pit 7 Pit privy 8 Sewage lagoon 9 Feedyard 10 Livestock pens 11 Fuel storage 12 Fertilizer storage 13 Insecticide storage 14 Abandoned water well 15 Oil well/Gas well 16 Other (specify below)	N/A
	Direction from well?	How many feet?

FROM	TO	PLUGGING MATERIALS
0	3	Top soil
3	55	Cement Grout
55	180	Chlorinated Gravel

7	CONTRACTOR'S OF LANDOWNER'S CERTIFICATION: This water well was plugged under my jurisdiction and was completed on (mo/day/year) 3/30/05 and this record is true to the best of my knowledge and belief. Kansas Water Well Contractor's License No. 208 This Water Well Record was completed on (mo/day/year) 4/4/05 under the business name of Minter-Wilson Drilling Co., Inc. by (signature) <i>Lora Keller</i>	
---	--	--

INSTRUCTIONS: Use typewriter or ball point pen. Please press firmly and print clearly. Please fill in blanks, underline or circle the correct answers. Send top three copies to Kansas Department of Health and Environment, Bureau of Water, Geology Section, 1000 SW Jackson St., Ste. 420, Topeka, Kansas 66612-1367. Telephone: 785/296-5522. Send one to Water Well Owner and retain one for your records.