

**WATER WELL PLUGGING RECORD Form WWC-5P**

KSA 82a-1212

ID NO.

 County: **Finney**

 Fraction  $\frac{1}{4}$  SW  $\frac{1}{4}$  SW  $\frac{1}{4}$  NE  $\frac{1}{4}$ 

 Section Number **27**

 Township Number **T 25 S**

 Range Number **32** ☐ E ☒ W

 Street Rural Address of Well Location: if unknown, distance & direction from nearest town or intersection: If at owner's address, check here ☐ Hwy 160 & Hwy 83 20 miles north on

Hwy 83 to Annie Sheer Road 2.75 east .5 south

**Global Positioning Systems (GPS) information:**

Latitude: \_\_\_\_\_ (in decimal degrees)

Longitude: \_\_\_\_\_ (in decimal degrees)

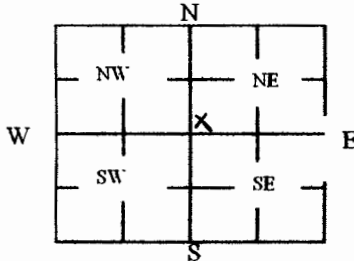
Elevation: \_\_\_\_\_

 Datum: ☐ WGS84. ☐ NAD83. ☐ NAD27

**Collection Method:**
☐ GPS unit (Make Model: \_\_\_\_\_)

☐ Digital Map Photo. ☐ Topographic Map. ☐ Land Survey

 Est. Accuracy: ☐ 3 m. ☐ 3-5 m. ☐ 5-15 m. ☐ 15 m

**3 MARK WELL'S LOCATION WITH AN "X" IN SECTION BOX:**

**4 DEPTH OF WELL 80 ft.**

 WELL'S STATIC WATER LEVEL none ft

**WELL WAS USED AS:**
☐ Domestic  
☐ Irrigation  
☐ Feedlot  
☐ Industrial

☒ Public Water Supply  
☒ Oil Field Water Supply  
☐ Domestic (Lawn & Garden)  
☐ Air Conditioning

☐ Dewatering  
☐ Monitoring  
☐ Injection Well  
☐ Other \_\_\_\_\_

 Was a chemical/bacteriological sample submitted to Department? Yes ☐ No ☒
**5 TYPE OF BLANK CASING USED:**
☒ Steel  
☐ PVC

☐ RMP (SR)  
☐ ABS

☐ Wrought  
☐ Asbestos-Cement

☐ Fiberglass  
☐ Concrete Tile

☐ Other (Specify below) \_\_\_\_\_

 Blank casing diameter 5 in. Was casing pulled? Yes ☐ No ☒ If yes, how much \_\_\_\_\_  
 Casing height above or below land surface 60 in.

**6 GROUT PLUG MATERIAL:** ☐ Neat cement ☒ Cement grout ☐ Bentonite ☐ Other \_\_\_\_\_

 Grout Plug Intervals: From 4 ft. to 80 ft., From \_\_\_\_\_ ft. to \_\_\_\_\_ ft., From \_\_\_\_\_ to \_\_\_\_\_ ft.

**What is the nearest source of possible contamination:**
☐ Septic tank  
☐ Sewer lines  
☐ Watertight sewer lines  
☐ Lateral lines  
☐ Cess pool

☐ Seepage pit  
☐ Pit privy  
☐ Sewage lagoon  
☐ Feedyard  
☐ Livestock pens

☐ Fuel Storage  
☐ Fertilizer storage  
☐ Insecticide storage  
☐ Abandoned water well  
☒ Oil well/Gas well

☐ Other (specify below) \_\_\_\_\_

 Direction from well? NE

 How many feet? 150

FROM	TO	PLUGGING MATERIALS	FROM	TO	PLUGGING MATERIALS
0	4	Top Soil			
4	80	Cement Grout			

 Original Returned to Sender  
 for Correction Date: 3/11/10
**7 CONTRACTOR'S OR LANDOWNER'S CERTIFICATION:** This water well was plugged under my jurisdiction and was completed on (mo/day/year) 3/4/2010 and this record is true to the best of my knowledge and belief. Kansas Water Well Contractor's License No. 775. This Water Well Record was completed on (mo/day/year) 3/13/2010 under the business name of Martin's Well Service by (signature) Kenny Martin
**INSTRUCTIONS:** Use typewriter or ballpoint pen. Please press firmly and print clearly. Please fill in blanks, underline or circle the correct answers. Send top three copies to Kansas Department of Health and Environment, Bureau of Water, Geology Section, 1000 SW Jackson St., Ste. 420, Topeka, Kansas 66612-1367. Telephone: 785/296-5524. Send one to Water Well Owner and retain one for your records. Visit us at <http://www.kdheks.gov/waterwell/index.html>.

 Check one: ☒ White Copy ☐ Blue Copy ☐ Pink Copy