CORRECTION(S) TO WATER WELL RECORD (WWC-5)
(to rectify lacking or incorrect information)

County: Finney

Location listed as:	**Location changed to:**
Section-Township-Range: 36-25 S-33 W	36-25 S-33 W
Fraction (¼ ¼ ¼): NE	NE NW NE NE

Other changes: Initial statements: _____

Changed to: _____

Comments: Wellsite address is 945 Maize Ct., Garden City, KS

verification method: Written & legal descriptions, Finney County Appraiser's online parcel search and GIS mapping tool, and KGS' online mapping tool & aerial photos. initials: DRL date: 4/21/2010

submitted by: Kansas Geological Survey, Data Resources Library, 1930 Constant Ave., Lawrence, KS 66047-3726
to: Kansas Dept of Health & Environment, Bureau of Water, 1000 SW Jackson, Suite 420, Topeka, KS 66612-1367.

WATER WELL RECORD Form WWC-5 KSA 82a-1212

1 LOCATION OF WATER WELL: County: Finney Co. | Fraction: ¼ NE ¼ ¼ | Section Number: 36 | Township Number: T 25 S | Range Number: R 33 E/W

Distance and direction from nearest town or city street address of well if located within city? 7m S of Garden City West Fork RD. Lot 2 Maize Ct. Windmill Estates

2 WATER WELL OWNER: Chuck ROACH
RR#, St. Address, Box # : 1217 Couch House Ct.
City, State, ZIP Code : Wichita, Ks. 67235
Board of Agriculture, Division of Water Resources Application Number:

3 LOCATE WELL'S LOCATION WITH AN "X" IN SECTION BOX:

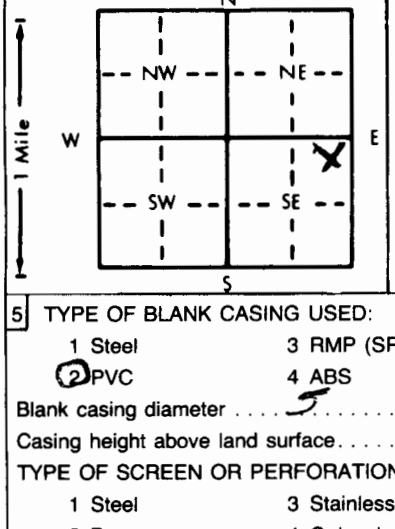

4 DEPTH OF COMPLETED WELL 334 ft. ELEVATION:
Depth(s) Groundwater Encountered 1. ft. 2. ft. 3. 9-24-94 ft.
WELL'S STATIC WATER LEVEL 158 ft. below land surface measured on mo/day/yr 9-24-94
Pump test data: Well water was ft. after hours pumping gpm
Est. Yield gpm: Well water was ft. after hours pumping gpm
Bore Hole Diameter 9 7/8 in. to 334 ft., and in. to ft.
WELL WATER TO BE USED AS: 1 Domestic 2 Irrigation 3 Feedlot 4 Industrial 5 Public water supply 6 Oil field water supply 7 Lawn and garden only 8 Air conditioning 9 Dewatering 10 Monitoring well 11 Injection well 12 Other (Specify below)
Was a chemical/bacteriological sample submitted to Department? Yes No X; If yes, mo/day/yr sample was submitted
Water Well Disinfected? Yes X No

5 TYPE OF BLANK CASING USED: 1 Steel 2 PVC 3 RMP (SR) 4 ABS 5 Wrought iron 6 Asbestos-Cement 7 Fiberglass 8 Concrete tile 9 Other (specify below)
CASING JOINTS: Glued X Clamped Welded Threaded
Blank casing diameter 5 in. to 294 ft., Dia in. to ft., Dia in. to ft.
Casing height above land surface 12 in., weight 200 lbs./ft. Wall thickness or gauge No.

TYPE OF SCREEN OR PERFORATION MATERIAL: 7 PVC
1 Steel 2 Brass 3 Stainless steel 4 Galvanized steel 5 Fiberglass 6 Concrete tile 8 RMP (SR) 9 ABS 10 Asbestos-cement 11 Other (specify) 12 None used (open hole)

SCREEN OR PERFORATION OPENINGS ARE: 1 Continuous slot 2 Louvered shutter 3 Mill slot 4 Key punched 5 Gauzed wrapped 6 Wire wrapped 7 Torch cut 8 Saw cut 9 Drilled holes 10 Other (specify) 11 None (open hole)

SCREEN-PERFORATED INTERVALS: From 294 ft. to 334 ft., From ft. to ft.
From ft. to ft., From ft. to ft.
GRAVEL PACK INTERVALS: From 30 ft. to 270 ft., From ft. to ft.
From 294 ft. to 334 ft., From ft. to ft.

6 GROUT MATERIAL: 1 Neat cement 2 Cement grout 3 Bentonite 4 Other
Grout Intervals: From 270 ft. to 294 ft., From 4 ft. to 30 ft., From ft. to ft.

What is the nearest source of possible contamination:
1 Septic tank 2 Sewer lines 3 Watertight sewer lines 4 Lateral lines 5 Cess pool 6 Seepage pit 7 Pit privy 8 Sewage lagoon 9 Feedyard 10 Livestock pens 11 Fuel storage 12 Fertilizer storage 13 Insecticide storage 14 Abandoned water well 15 Oil well/Gas well 16 Other (specify below)
Direction from well? How many feet? Field

FROM	TO	LITHOLOGIC LOG
0	6	Top Soil
6	50	Brown Sandy Clay
50	52	Hard Rock
52	61	Fine to med gravel (loose)
61	125	Course gravel (loose) Fld St.
125	127	Hard Rock
127	150	Fine to med Sand & gravel (loose) few St. Hd Rock & clay
150	233	Blue clay Hd Streak
233	235	Hard Rock
235	237	Blue clay
237	238	Hard Rock
238	246	Blue Clay
246	250	Fine to med Sand & gravel (loose)
250	260	Brown Sandy clay
260	277	Blue Clay Hard St
277	282	Fine to med Sand & gravel Loose
282	307	Brown Sandy clay Hd St Rock
307	312	Fine to med Sand & gravel
312	320	Brown Sandy clay (loose)
320	334	Fine to med Sand & gravel loose st clay

PLUGGING INTERVALS

7 CONTRACTOR'S OR LANDOWNER'S CERTIFICATION: This water well was (1) constructed, (2) reconstructed, or (3) plugged under my jurisdiction and was completed on (mo/day/year) 9-24-09 and this record is true to the best of my knowledge and belief. Kansas Water Well Contractor's License No. 172 This Water Well Record was completed on (mo/day/yr) 3-25-10
under the business name of Morgan Water Well (signature) mg

INSTRUCTIONS: Use typewriter or ball point pen. *PLEASE PRESS FIRMLY* and *PRINT* clearly. Please fill in blanks, underline or circle the correct answers. Send top three copies to Kansas Department of Health and Environment, Bureau of Water, Topeka, Kansas 66620-0001. Telephone: 913-296-5545. Send one to WATER WELL OWNER and retain one for your records.