

CORRECTION(S) TO WATER WELL RECORD (WWC-5)

(to rectify lacking or incorrect information)

County: Finney

Location listed as:

Section-Township-Range: 36-255-33 W

Fraction ($\frac{1}{4}$ $\frac{1}{4}$ $\frac{1}{4}$): NE

Location changed to:

36-255-33 W

S2 NW SE NE

Other changes: Initial statements: _____

Changed to: _____

Comments: Wellsite address is 945 Mimosa Ct., Garden City, KS.

verification method: Written & legal descriptions, Finney County Appraiser's
online parcel search and GIS mapping tool, and KGS'
online mapping tool & aerial photos. initials: DRB date: 4/21/2010

submitted by: Kansas Geological Survey, Data Resources Library, 1930 Constant Ave., Lawrence, KS 66047-3726

to: Kansas Dept of Health & Environment, Bureau of Water, 1000 SW Jackson, Suite 420, Topeka, KS 66612-1367.

1 LOCATION OF WATER WELL:	Fraction	Section Number	Township Number	Range Number
County: <u>Finney</u>	$\frac{1}{4}$ $\frac{1}{4}$ <u>NE</u> $\frac{1}{4}$	<u>36</u>	T <u>25</u> S	R <u>33</u> <u>EW</u>

Distance and direction from nearest town or city street address of well if located within city?

Lot 22 meadow Ct. Wendell Estate

2 WATER WELL OWNER:

RR#, St. Address, Box # :

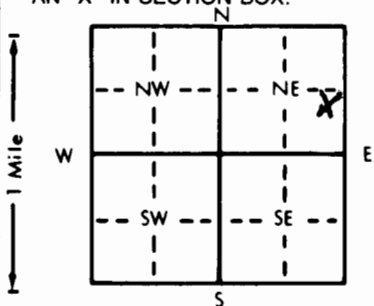
City, State, ZIP Code :

Chuck Rouch
1217 Coach House Ct.
Wichita, KS 67235

Board of Agriculture, Division of Water Resources

Application Number:

3 LOCATE WELL'S LOCATION WITH AN "X" IN SECTION BOX:

4 DEPTH OF COMPLETED WELL: 322 ft. ELEVATION:

Depth(s) Groundwater Encountered 1. ft. 2. ft. 3. ft.

WELL'S STATIC WATER LEVEL 15.4 ft. below land surface measured on mo/day/yr 9-25-95

Pump test data: Well water was ft. after hours pumping gpm

Est. Yield gpm: Well water was ft. after hours pumping gpm

Bore Hole Diameter 10 in. to 330 ft., and in. to ft.

WELL WATER TO BE USED AS: 5 Public water supply 8 Air conditioning 11 Injection well

☒ 1 Domestic 3 Feedlot 6 Oil field water supply 9 Dewatering 12 Other (Specify below)

2 Irrigation 4 Industrial 7 Lawn and garden only 10 Monitoring well

Was a chemical/bacteriological sample submitted to Department? Yes. No. X; If yes, mo/day/yr sample was submitted

Water Well Disinfected? Yes No

5 TYPE OF BLANK CASING USED:

- 1 Steel 3 RMP (SR)
☒ 2 PVC 4 ABS

5 Wrought iron

8 Concrete tile

CASING JOINTS: Glued X Clamped

6 Asbestos-Cement

9 Other (specify below)

Welded

7 Fiberglass

Threaded

Blank casing diameter in. to ft., Dia in. to ft., Dia in. to ft.

Casing height above land surface 18 in., weight 200 lbs./ft. Wall thickness or gauge No.

TYPE OF SCREEN OR PERFORATION MATERIAL:

- 1 Steel 3 Stainless steel
 2 Brass 4 Galvanized steel

5 Fiberglass

☒ PVC

10 Asbestos-cement

8 RMP (SR)

11 Other (specify)

6 Concrete tile

9 ABS

12 None used (open hole)

SCREEN OR PERFORATION OPENINGS ARE:

- 1 Continuous slot ☒ 3 Mill slot
 2 Louvered shutter 4 Key punched

5 Gauzed wrapped

8 Saw cut

11 None (open hole)

6 Wire wrapped

9 Drilled holes

7 Torch cut

10 Other (specify)

SCREEN-PERFORATED INTERVALS: From 294 ft. to 322 ft., From ft. to ft.From 40 ft. to 260 ft., From ft. to ft.GRAVEL PACK INTERVALS: From 294 ft. to 322 ft., From ft. to ft.

6 GROUT MATERIAL:

1 Neat cement

2 Cement grout

☒ 3 Bentonite

4 Other

Grout intervals: From 4 ft. to 30 ft., From ft. to ft., From ft. to ft.

What is the nearest source of possible contamination:

- 1 Septic tank 4 Lateral lines
 2 Sewer lines 5 Cess pool
 3 Watertight sewer lines 6 Seepage pit

7 Pit privy

8 Sewage lagoon

9 Feedyard

10 Livestock pens

11 Fuel storage

12 Fertilizer storage

13 Insecticide storage

14 Abandoned water well

15 Oil well/Gas well

16 Other (specify below)

Pasture

Direction from well?

How many feet?

FROM	TO	LITHOLOGIC LOG	FROM	TO	PLUGGING INTERVALS
0	8	Top Soil	300	327	Line to med Sand & gravel (loose)
8	50	Brown Sandy clay			
50	60	Line to med Sand & gravel (loose)			
60	128	Coarse gravel (loose) mixed w/ Rock			
128	141	Blue & gray clay	327-330		Brown clay
141	154	Brown Sandy clay			
154	265	Blue clay (stiff)			
265	282	Brown Sandy clay & line to med Sand & gravel (loose)			
282	286	Line to med sand & gravel (loose)			
286	287	Hard Rock			
287	289	Line to med Sand & gravel (loose)			
289	291	Brown Sandy clay			
291	295	Line to med Sand & gravel (loose)			
295	300	mix with little Reddish Sand			
		Brown Sandy clay			

7 CONTRACTOR'S OR LANDOWNER'S CERTIFICATION: This water well was ☒ (1) constructed, (2) reconstructed, or (3) plugged under my jurisdiction and was completed on (mo/day/year) 9-25-95 and this record is true to the best of my knowledge and belief. KansasWater Well Contractor's License No. 172This Water Well Record was completed on (mo/day/yr) 3-30-10under the business name of Tonogon Water Well Serv'sby (signature) me