

CORRECTION(S) TO WATER WELL RECORD (WWC-5)

(to rectify lacking or incorrect information)

County: Finney

Location listed as:

Location changed to:

Section-Township-Range: 36-25S-33W36-25S-33WFraction ($\frac{1}{4}$ $\frac{1}{4}$ $\frac{1}{4}$): NESE SW SE NE

Other changes: Initial statements: _____

Changed to: _____

Comments: Well site address is 945 Crabapple Ct., Garden City, KS.verification method: Written & legal descriptions, Finney County Appraiser's online parcel search and GIS mapping tool, and KGS' online mapping tool & aerial photos. initials: DRL date: 4/21/2010

submitted by: Kansas Geological Survey, Data Resources Library, 1930 Constant Ave., Lawrence, KS 66047-3726

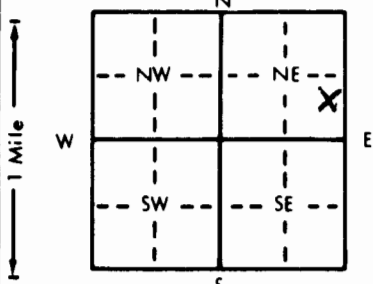
to: Kansas Dept of Health & Environment, Bureau of Water, 1000 SW Jackson, Suite 420, Topeka, KS 66612-1367.

1 LOCATION OF WATER WELL: County: <u>Finney</u>	Fraction $\frac{1}{4}$ $\frac{1}{4}$ <u>NE</u> $\frac{1}{4}$	Section Number <u>36</u>	Township Number T <u>25</u> S	Range Number R <u>33</u> EW
--	---	-----------------------------	----------------------------------	--------------------------------

Distance and direction from nearest town or city street address of well if located within city?

Crebapple Ct. Lot 32 Windmill Estate

2 WATER WELL OWNER: RR#, St. Address, Box # : City, State, ZIP Code :	<u>Chuck Road</u> <u>1217 Coach House Ct.</u> <u>Wichita, KS 67235</u>	Board of Agriculture, Division of Water Resources Application Number:
---	--	--

3 LOCATE WELL'S LOCATION WITH AN "X" IN SECTION BOX: 	4 DEPTH OF COMPLETED WELL: <u>290</u> ft. ELEVATION: Depth(s) Groundwater Encountered 1. ft. 2. ft. 3. ft. WELL'S STATIC WATER LEVEL <u>174</u> ft. below land surface measured on mo/day/yr <u>7-9-94</u> Pump test data: Well water was ft. after hours pumping gpm Est. Yield gpm Well water was ft. after hours pumping gpm Bore Hole Diameter <u>10</u> in. to <u>290</u> ft., and in. to ft. WELL WATER TO BE USED AS: ① Domestic 3 Feedlot 6 Oil field water supply 9 Dewatering 12 Other (Specify below) 2 Irrigation 4 Industrial 7 Lawn and garden only 10 Monitoring well Was a chemical/bacteriological sample submitted to Department? Yes No <u>X</u> If yes, mo/day/yr sample was submitted Water Well Disinfected? Yes <u>X</u> No
--	--

5 TYPE OF BLANK CASING USED: 1 Steel 3 RMP (SR) 5 Wrought iron 8 Concrete tile CASING JOINTS: Glued <u>X</u> Clamped ② PVC 4 ABS 6 Asbestos-Cement 9 Other (specify below) Welded 7 Fiberglass Threaded Blank casing diameter <u>5</u> in. to <u>260</u> ft., Dia. in. to ft., Dia. in. to ft. Casing height above land surface <u>18</u> in., weight <u>200</u> lbs./ft. Wall thickness or gauge No. TYPE OF SCREEN OR PERFORATION MATERIAL: 1 Steel 3 Stainless steel 5 Fiberglass 8 RMP (SR) 10 Asbestos-cement 2 Brass 4 Galvanized steel 6 Concrete tile 9 ABS 11 Other (specify) 12 None used (open hole) SCREEN OR PERFORATION OPENINGS ARE: 1 Continuous slot ③ Mill slot 5 Gauzed wrapped 8 Saw cut 11 None (open hole) 2 Louvered shutter 4 Key punched 6 Wire wrapped 9 Drilled holes 7 Torch cut 10 Other (specify) SCREEN-PERFORATED INTERVALS: From <u>260</u> ft. to <u>290</u> ft., From ft. to ft. GRAVEL PACK INTERVALS: From <u>30</u> ft. to <u>240</u> ft., From ft. to ft. From <u>260</u> ft. to <u>290</u> ft., From ft. to ft.
--

6 GROUT MATERIAL: Grout Intervals: From <u>4</u> ft. to <u>30</u> ft., From <u>240</u> ft. to <u>260</u> ft., From ft. to ft. What is the nearest source of possible contamination: 1 Septic tank 4 Lateral lines 7 Pit privy 10 Livestock pens 14 Abandoned water well 2 Sewer lines 5 Cess pool 8 Sewage lagoon 11 Fuel storage 15 Oil well/Gas well 3 Watertight sewer lines 6 Seepage pit 9 Feedyard 12 Fertilizer storage 16 Other (specify below) 13 Insecticide storage <u>Pasture</u> Direction from well? How many feet?
--

FROM	TO	LITHOLOGIC LOG	FROM	TO	PLUGGING INTERVALS
0	21	fine Sand	225	232	Brown Sandy clay
21	53	Brown Sandy clay	232	235	fine to med Sand & gravel
53	146	fine to med Sand & gravel	235	238	Brown Sandy clay
146	149	(loose) St clay	238	240	fine to med Sand & gravel
149	179	Hard Rock	240	256	Brown clay (Sticky)
179	181	fine to med Sand & gravel	256	258	Rock
181	185	(loose) St clay	258	268	Rock & clay
185	200	Hard Rock	268	280	fine to med Sand & gravel
200	211	Brown clay	280	285	Rock
211	217	Brown Sandy clay	285	289	gravel
217	218	Brown clay (Sticky)	289	290	Rock
218	223	fine Sand & gravel			
223	225	Hard Rock			
		Brown clay			
		fine to med Sand			

7 CONTRACTOR'S OR LANDOWNER'S CERTIFICATION: This water well was ① constructed, (2) reconstructed, or (3) plugged under my jurisdiction and was completed on (mo/day/year) <u>7-9-94</u> and this record is true to the best of my knowledge and belief. Kansas Water Well Contractor's License No. <u>172</u> This Water Well Record was completed on (mo/day/yr) <u>3-30-70</u> under the business name of <u>Jonagan Water Well Service</u> by (signature) <u>meq</u>
--