


0851

1 LOCATION OF WATER WELL: Fraction Section Number Township Number Range Number
 COUNTY: 028 FINNEY SE 1/4 NW 1/4 NW 1/4 13 T 25 S R 34 W

Distance and direction from nearest town or city street address of well if located within city?
 FROM HOLCOMB; APPX 6 1/2 MILES SOUTH

2 WATER WELL OWNER: SUNFLOWER ELECTRIC POWER
 RR#, St. Address, Box #: PO BOX 430 Board of Agriculture, Division of Water Resources
 City, State, ZIP code: HOLCOMB, KS 67851-0430 Application Number:

3 LOCATE WELL'S LOCATION WITH
 AN "X" IN SECTION BOX:

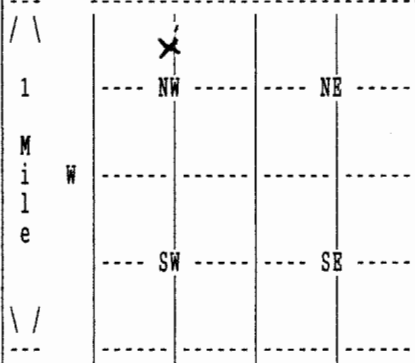

4 DEPTH OF COMPLETED WELL 437 ELEVATION: 0
 Depth(s) Groundwater Encountered 1. 0 ft. 2. 0 ft. 3. 0 ft.

WELL'S STATIC WATER LEVEL 201 ft. below land surface measured on mo/day/yr 5-17-05
 Pump test data: Well water was 0 ft. after 0 hours pumping 0 gpm

Estimated Yield 0 gpm: Well water was 0 ft. after 0 hours pumping 0 gpm

Bore Hole Diameter 9 7/8 in. to 437 ft., and in. to 0 ft.

WELL WATER TO BE USED AS: 10 MONITORING

Was a chemical/bacteriological sample submitted to department? No;
 If yes, mo/day/yr sample was submitted Water well disinfected? Yes

5 TYPE OF BLANK CASING USED: 02 PVC CASING JOINTS: GLUED
 Blank casing diameter 4 in. to 437 ft., Dia in. to 0 ft., Dia in. to 0 ft.
 Casing height above land surface 12 in., weight 3 lbs/ft. Wall thickness or gauge No. .337
 TYPE OF SCREEN OR PERFORATION MATERIAL: 07 PVC
 SCREEN OR PERFORATION OPENINGS ARE: 03 MILL SLOT

SCREEN PERFORATED INTERVALS: From 357 ft. to 437 ft., From 0 ft. to 0 ft.
 From 0 ft. to 0 ft., From 0 ft. to 0 ft.
 GRAVEL PACK INTERVALS: From 20 ft. to 140 ft., From 0 ft. to 0 ft.
 From 150 ft. to 437 ft., From 0 ft. to 0 ft.

6 GROUT MATERIAL 03 BENTONITE
 Grout Intervals: From 0 ft. to 20 ft., From 140 ft. to 150 ft., From 0 ft. to 0 ft.
 What is the nearest source of possible contamination: NONE OBSERVED
 Direction from well? How many feet? 0

| FROM | TO | LITHOLOGIC LOG | FROM | TO | PLUGGING INTERVALS |
|------|-----|--------------------------------------|------|----|--------------------|
| 0 | 2 | 02 SILT | | | |
| 2 | 24 | 04 SANDY CLAY 07 FINE SAND | | | |
| 24 | 53 | 05 SAND 11 GRAVEL | | | |
| 53 | 58 | 04 SANDY CLAY | | | |
| 58 | 61 | 05 SAND 13 FINE GRAVEL 14 MED GRAVEL | | | |
| 61 | 128 | 04 SANDY CLAY 05 SAND | | | |
| 128 | 167 | 01 CLAY | | | |
| 167 | 174 | 05 SAND 13 FINE GRAVEL | | | |
| 174 | 238 | 01 CLAY | | | |
| 238 | 296 | 05 SAND | | | |

7 CONTRACTOR'S OR LANDOWNER'S CERTIFICATION: This water well was Constructed under my jurisdiction and was completed on (mo/day/year) 03/04/05 and this record is true to the best of my knowledge and belief. Kansas
 Water Well Contractor's License No. 145 This Water Well Record was completed on (mo/day/yr) 04/13/05
 under the business name of HENKLE DRILLING & SUPPLY by (signature)

(Continued)

WATER WELL RECORD Form WWC-5 KSA 82a-1212

| | | | | |
|---------------------------|----------------|----------------|-----------------|--------------|
| 1 LOCATION OF WATER WELL: | Fraction | Section Number | Township Number | Range Number |
| COUNTY: 028 FINNEY | 1/4 1/4 NW 1/4 | 13 | T 25 S | R 34 W |

2 WATER WELL OWNER: SUNFLOWER ELECTRIC POWER
RR#, St. Address, Box # : PO BOX 430
City, State, ZIP code : HOLCOMB, KS 67851-0430

Board of Agriculture, Division of Water Resources
Application Number:

| FROM | TO | LITHOLOGIC LOG |
|------|-----|-----------------------|
| 296 | 321 | 04 SANDY CLAY 05 SAND |
| 321 | 360 | 05 SAND |
| 360 | 389 | 04 SANDY CLAY 05 SAND |
| 389 | 420 | 05 SAND 01 CLAY |
| 420 | 430 | 04 SANDY CLAY 05 SAND |
| 430 | 440 | 31 CALICHE |

7 CONTRACTOR'S OR LANDOWNER'S CERTIFICATION: This water well was Constructed under my jurisdiction and was completed on (mo/day/year) 03/04/05 and this record is true to the best of my knowledge and belief. Kansas
Water Well Contractor's License No. 145 This Water Well Record was completed on (mo/day/yr) 04/13/05
under the business name of HENKLE DRILLING & SUPPLY by (signature) *Bernie Richman*