

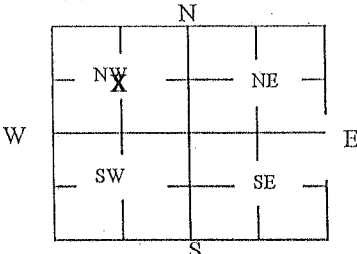
## WATER WELL PLUGGING RECORD Form WWC-5P

KSA 82a-1212

ID NO.

26,082

1 LOCATION OF WATER WELL: County: <b>Finney</b>		Fraction <b>NC</b> $\frac{1}{4}$ $\frac{1}{4}$ $\frac{1}{4}$ <b>NW</b> $\frac{1}{4}$	Section Number <b>30</b>	Township Number <b>T 25 S</b>	Range Number <b>34</b> <input type="checkbox"/> E <input checked="" type="checkbox"/> W
Street/Rural Address of Well Location; if unknown, distance & direction from nearest town or intersection: If at owner's address, check here <input type="checkbox"/> <b>Holcomb-4 Miles South, 1 Mile West, 5 Miles South, 4 Miles West, 3,960 Ft. North &amp; 3,960 Ft. West</b>			Global Positioning Systems (GPS) information: Latitude: _____ (in decimal degrees) Longitude: _____ (in decimal degrees) Elevation: _____ Datum: <input type="checkbox"/> WGS84, <input type="checkbox"/> NAD83, <input type="checkbox"/> NAD27 Collection Method: <input type="checkbox"/> GPS unit (Make/Model: _____) <input type="checkbox"/> Digital Map/Photo, <input type="checkbox"/> Topographic Map, <input type="checkbox"/> Land Survey Est. Accuracy: <input type="checkbox"/> <3 m, <input type="checkbox"/> 3-5 m, <input type="checkbox"/> 5-15 m, <input type="checkbox"/> >15 m		
2 WATER WELL OWNER: <b>Wheatland Electric</b> RR#, St. Address, Box #: <b>Coop, Inc., PO Box 230</b> City, State ZIP Code: <b>Scott City, KS 67871</b>					

3 MARK WELL'S LOCATION WITH AN "X" IN SECTION BOX: 	4 DEPTH OF WELL <b>427</b> ft. WELL'S STATIC WATER LEVEL <b>270</b> ft. WELL WAS USED AS: <input checked="" type="checkbox"/> Domestic <input checked="" type="checkbox"/> Irrigation <input type="checkbox"/> Feedlot <input type="checkbox"/> Industrial <input type="checkbox"/> Public Water Supply <input type="checkbox"/> Oil Field Water Supply <input type="checkbox"/> Domestic (Lawn & Garden) <input type="checkbox"/> Air Conditioning <input type="checkbox"/> Dewatering <input type="checkbox"/> Monitoring <input type="checkbox"/> Injection Well <input type="checkbox"/> Other _____ Was a chemical/bacteriological sample submitted to Department? Yes <input type="checkbox"/> No <input checked="" type="checkbox"/>
---	--

5 TYPE OF BLANK CASING USED:  
☒ Steel ☐ RMP (SR) ☐ Wrought ☐ Fiberglass ☐ Other (Specify below)  
☐ PVC ☐ ABS ☐ Asbestos-Cement ☐ Concrete Tile  
 Blank casing diameter **16** in. Was casing pulled? Yes ☒ No ☐ If yes, how much **3 Ft.**  
 Casing height above or below land surface **36** in. **Below**

6 GROUT PLUG MATERIAL: ☐ Neat cement ☒ Cement grout ☐ Bentonite ☐ Other \_\_\_\_\_  
 Grout Plug Intervals: From **3** ft. to **270** ft., From \_\_\_\_\_ ft. to \_\_\_\_\_ ft., From \_\_\_\_\_ to \_\_\_\_\_ ft.  
 What is the nearest source of possible contamination:  
☐ Septic tank ☐ Seepage pit ☐ Fuel Storage ☐ Other (specify below)  
☐ Sewer lines ☐ Pit privy ☐ Fertilizer storage **N/A**  
☐ Watertight sewer lines ☐ Sewage lagoon ☐ Insecticide storage  
☐ Lateral lines ☐ Feedyard ☐ Abandoned water well Direction from well? \_\_\_\_\_  
☐ Cess pool ☐ Livestock pens ☐ Oil well/Gas well How many feet? \_\_\_\_\_

FROM	TO	PLUGGING MATERIALS	FROM	TO	PLUGGING MATERIALS
<b>0</b>	<b>3</b>	<b>Top Soil</b>			
<b>3</b>	<b>270</b>	<b>Cement Grout</b>			
<b>270</b>	<b>427</b>	<b>Chlorinated Gravel</b>			

7 CONTRACTOR'S OR LANDOWNER'S CERTIFICATION: This water well was plugged under my jurisdiction and was completed on (mo/day/year) **10-14-11** and this record is true to the best of my knowledge and belief. Kansas Water Well Contractor's License No. **208**. This Water Well Record was completed on (mo/day/year) **10-18-11** under the business name of **Minter-Wilson Drilling Co., Inc.** by (signature) *Para Keller*

INSTRUCTIONS: Use typewriter or ballpoint pen. Please press firmly and print clearly. Please fill in blanks, underline or circle the correct answers. Send top three copies to Kansas Department of Health and Environment, Bureau of Water, Geology Section, 1000 SW Jackson St., Ste. 420, Topeka, Kansas 66612-1367. Telephone: 785/296-5524. Send one to Water Well Owner and retain one for your records. Visit us at <http://www.kdheks.gov/waterwell/index.html>.

Check one: ☒ White Copy ☐ Blue Copy ☐ Pink Copy