


1 LOCATION OF WATER WELL: Fraction **SW 1/4 SW 1/4 NE 1/4** Section Number **20** Township Number **T 25 S** Range Number **R 35 EW**
 County: **Kearny**

Distance and direction from nearest town or city street address of well if located within city?
S. side of lakin: 1S., 1/4E., 6S., 3 1/2E., 2 1/2N into

2 WATER WELL OWNER: **Minter Wilson** **Fletcher Ranch**
 RR#, St. Address, Box #: **P.O. Box A** Board of Agriculture, Division of Water Resources
 City, State, ZIP Code: **Garden City, KS. 67846** Application Number:

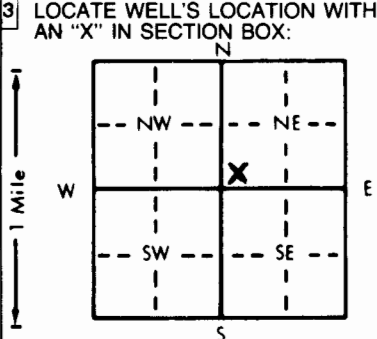

4 DEPTH OF COMPLETED WELL: **385** ft. ELEVATION:
 Depth(s) Groundwater Encountered 1. **130** ft. 2. ft. 3. ft.
 WELL'S STATIC WATER LEVEL **130** ft. below land surface measured on mo/day/yr **11-11-96**
 Pump test data: Well water was **175** ft. after **1** hours pumping **95** gpm
 Est. Yield **95** gpm: Well water was ft. after hours pumping gpm
 Bore Hole Diameter **9 1/4** in. to **385** ft., and in. to ft.
 WELL WATER TO BE USED AS: 5 Public water supply 8 Air conditioning 11 Injection well
 1 Domestic 3 Feedlot 6 Oil field water supply 9 Dewatering 12 Other (Specify below)
 2 Irrigation 4 Industrial 7 Lawn and garden only 10 Monitoring well
 Was a chemical/bacteriological sample submitted to Department? Yes.....No ; If yes, mo/day/yr sample was sub-
 mitted Water Well Disinfected? Yes No

5 TYPE OF BLANK CASING USED: 5 Wrought iron 8 Concrete tile CASING JOINTS: Glued Clamped
 1 Steel 3 RMP (SR) 6 Asbestos-Cement 9 Other (specify below) Welded
 2 PVC 4 ABS 7 Fiberglass Threaded.....
 Blank casing diameter **5** in. to **380** ft., Dia in. to ft., Dia in. to ft.
 Casing height above land surface **24** in., weight **2.902** lbs./ft. Wall thickness or gauge No. **280 SDR 21**
 TYPE OF SCREEN OR PERFORATION MATERIAL: 7 PVC 10 Asbestos-cement
 1 Steel 3 Stainless steel 5 Fiberglass 8 RMP (SR) 11 Other (specify)
 2 Brass 4 Galvanized steel 6 Concrete tile 9 ABS 12 None used (open hole)
 SCREEN OR PERFORATION OPENINGS ARE: 5 Gauzed wrapped 8 Saw cut 11 None (open hole)
 1 Continuous slot 3 Mill slot 6 Wire wrapped 9 Drilled holes
 2 Louvered shutter 4 Key punched 7 Torch cut 10 Other (specify)
 SCREEN-PERFORATED INTERVALS: From **280** ft. to **380** ft., From ft. to ft.
 From ft. to ft., From ft. to ft.
 GRAVEL PACK INTERVALS: From **180** ft. to **385** ft., From ft. to ft.
 From ft. to ft., From ft. to ft.

6 GROUT MATERIAL: 1 Neat cement 2 Cement grout 3 Bentonite 4 Other **Hole Plug**
 Grout Intervals: From **0** ft. to **16** ft., From ft. to ft., From ft. to ft.
 What is the nearest source of possible contamination:
 1 Septic tank 4 Lateral lines 7 Pit privy 10 Livestock pens 14 Abandoned water well
 2 Sewer lines 5 Cess pool 8 Sewage lagoon 11 Fuel storage 15 Oil well/Gas well
 3 Watertight sewer lines 6 Seepage pit 9 Feedyard 12 Fertilizer storage 16 Other (specify below)
 13 Insecticide storage
 Direction from well? How many feet?

FROM	TO	LITHOLOGIC LOG	FROM	TO	PLUGGING INTERVALS
0	3	Surface			
3	12	Sandy Clay			
12	91	Sand & Gravel			
91	129	Sandy Clay			
129	177	Blue Clay			
177	210	Sand & Clay Streaks			
210	261	Sand			
261	282	Clay			
282	314	Sand			
314	341	Clay			
341	375	Sand			
375	385	Clay			

7 CONTRACTOR'S OR LANDOWNER'S CERTIFICATION: This water well was (1) constructed, (2) reconstructed, or (3) plugged under my jurisdiction and was completed on (mo/day/year) **11-11-96** and this record is true to the best of my knowledge and belief. Kansas Water Well Contractor's License No. **KWCL - 430** This Water Well Record was completed on (mo/day/yr) **11-11-96** under the business name of **Howard Drlg. Box 806, Beaver, Ok 73932** by (signature) *[Signature]*