


1 LOCATION OF WATER WELL: County: Kearny Fraction: SE 1/4 SW 1/4 SE 1/4 Section Number: 11 Township Number: T 25 S Range Number: R 35 E **(W)**

Distance and direction from nearest town or city street address of well if located within city? 630 ft. north
 From South Side of Deerfield - 3/4 mile southeast, 1/4 mile northeast, 5 1/2 Miles south 1390 ft. west

2 WATER WELL OWNER: George H. Tate III
 RR#, St. Address, Box #: 1325 Hineman Drive Board of Agriculture, Division of Water Resources
 City, State, ZIP Code: Garden City, Kansas 67846 Application Number: 20,931

3 LOCATE WELL'S LOCATION WITH AN "X" IN SECTION BOX:

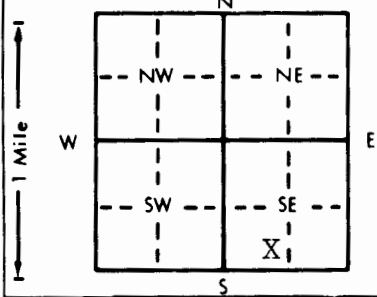

4 DEPTH OF COMPLETED WELL: 430 ft. ELEVATION: _____
 Depth(s) Groundwater Encountered 1. _____ ft. 2. _____ ft. 3. _____ ft.
 WELL'S STATIC WATER LEVEL: 154 ft. below land surface measured on mo/day/yr 3/20/97
 Pump test data: Well water was _____ ft. after _____ hours pumping _____ gpm
 Est. Yield _____ gpm: Well water was _____ ft. after _____ hours pumping _____ gpm
 Bore Hole Diameter: 30 in. to 430 ft., and _____ in. to _____ ft.
 WELL WATER TO BE USED AS: 5 Public water supply 8 Air conditioning 11 Injection well
 1 Domestic 3 Feedlot 6 Oil field water supply 9 Dewatering 12 Other (Specify below)
 ② Irrigation 4 Industrial 7 Lawn and garden only 10 Monitoring well _____
 Was a chemical/bacteriological sample submitted to Department? Yes _____ No X; If yes, mo/day/yr sample was submitted _____
 Water Well Disinfected? Yes _____ No X

5 TYPE OF BLANK CASING USED: ① Steel 3 RMP (SR) 5 Wrought iron 8 Concrete tile CASING JOINTS: Glued _____ Clamped _____
 2 PVC 4 ABS 6 Asbestos-Cement 9 Other (specify below) Welded X
 7 Fiberglass Threaded _____

Blank casing diameter: 16 in. to 420 ft., Dia. 20" in. to See below ft., Dia. _____ in. to _____ ft.
 Casing height above land surface: 12 in., weight 16"-42.05 lbs./ft. Wall thickness or gauge No. 250

TYPE OF SCREEN OR PERFORATION MATERIAL: 20"-52.73 7 PVC 10 Asbestos-cement
 ① Steel 3 Stainless steel 5 Fiberglass 8 RMP (SR) 11 Other (specify) _____
 2 Brass 4 Galvanized steel 6 Concrete tile 9 ABS 12 None used (open hole)

SCREEN OR PERFORATION OPENINGS ARE: 5 Gauzed wrapped 8 Saw cut 11 None (open hole)
 1 Continuous slot ③ Mill slot ⑥ Wire wrapped 9 Drilled holes
 2 Louvered shutter 4 Key punched ⑦ Torch cut 10 Other (specify) _____

SCREEN-PERFORATED INTERVALS: From See below ft. to _____ ft., From _____ ft. to _____ ft.
 From _____ ft. to _____ ft., From _____ ft. to _____ ft.
 GRAVEL PACK INTERVALS: From 20 ft. to 110 ft., From 170 ft. to 430 ft.
 From _____ ft. to _____ ft., From _____ ft. to _____ ft.

6 GROUT MATERIAL: 1 Neat cement ② Cement grout 3 Bentonite 4 Other _____
 Grout Intervals: From 0 ft. to 20 ft., From 110 ft. to 170 ft., From _____ ft. to _____ ft.

What is the nearest source of possible contamination:
 1 Septic tank 4 Lateral lines 7 Pit privy 10 Livestock pens 14 Abandoned water well
 2 Sewer lines 5 Cess pool 8 Sewage lagoon 11 Fuel storage 15 Oil well/Gas well
 3 Watertight sewer lines 6 Seepage pit 9 Feedyard 12 Fertilizer storage 16 Other (specify below)
 13 Insecticide storage _____ N/A _____

Direction from well? _____ How many feet? _____

FROM	TO	LITHOLOGIC LOG	FROM	TO	PLUGGING INTERVALS
		See attached log			
0	180	16" Plain Casing			
180	230	16" Plain Casing X 20" Screen			
230	250	16" Plain Casing X 20" Plain Casing			
250	260	16" Plain Casing X 20" Screen			
260	270	16" Plain Casing X 20" Plain Casing			
270	280	16" Plain Casing X 20" Screen			
280	300	16" Plain Casing X 20" Plain Casing			
300	330	16" Plain Casing X 20" Perf. Casing			
330	350	16" Plain Casing X 20" Plain Casing			
350	360	16" Plain Casing X 20" Perf. Casing			
360	400	16" Plain Casing X 20" Screen			
400	420	16" Plain Casing X 20" Perf. Casing			
420	430	20" Plain Casing X 16" Torch Cut Perf. Casing			

7 CONTRACTOR'S OR LANDOWNER'S CERTIFICATION: This water well was ① constructed, (2) reconstructed, or (3) plugged under my jurisdiction and was completed on (mo/day/year) 3-20-97 and this record is true to the best of my knowledge and belief. Kansas Water Well Contractor's License No. 208 This Water Well Record was completed on (mo/day/yr) 3-25-97 under the business name of Minter-Wilson Drilling Co., Inc. by (signature) Nora Keller