


1 LOCATION OF WATER WELL: Fraction NW 1/4 NW 1/4 NW 1/4 Section Number 7 Township Number T 25 S Range Number R 35 E (W)
 County: Kearny

Distance and direction from nearest town or city street address of well if located within city?
From Lakin 2 miles South on Hwy. 25. Then 2 miles east

2 WATER WELL OWNER: Lakin Mennonite Church
 RR#, St. Address, Box #: Rt. 2 Box 100 Board of Agriculture, Division of Water Resources
 City, State, ZIP Code: Lakin, KS. 67860 Application Number:

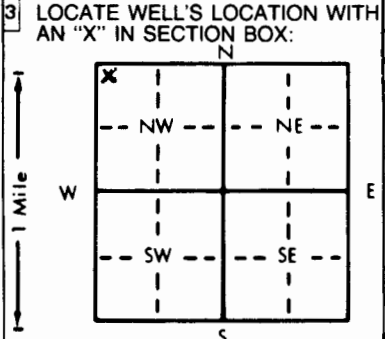

4 DEPTH OF COMPLETED WELL: 320 ft. ELEVATION:
 Depth(s) Groundwater Encountered 1. ft. 2. ft. 3. ft.
 WELL'S STATIC WATER LEVEL: 94 ft. below land surface measured on mo/day/yr 6-17-97
 Pump test data: Well water was ft. after hours pumping gpm
 Est. Yield gpm: Well water was ft. after hours pumping gpm
 Bore Hole Diameter: 9 7/8 in. to 320 ft., and in. to ft.
 WELL WATER TO BE USED AS:
 1 Domestic 3 Feedlot 6 Oil field water supply 9 Dewatering 12 Other (Specify below)
 2 Irrigation 4 Industrial 7 Lawn and garden only 10 Monitoring well
 Was a chemical/bacteriological sample submitted to Department? Yes No ; If yes, mo/day/yr sample was submitted
 Water Well Disinfected? Yes No

5 TYPE OF BLANK CASING USED:
 1 Steel 3 RMP (SR) 5 Wrought iron 8 Concrete tile CASING JOINTS: Glued Clamped
 2 PVC 4 ABS 6 Asbestos-Cement 9 Other (specify below) Welded
 7 Fiberglass Threaded
 Blank casing diameter: 5" in. to 280 ft., Dia in. to ft., Dia in. to ft.
 Casing height above land surface: 12 in., weight lbs./ft. Wall thickness or gauge No. 50R21
 TYPE OF SCREEN OR PERFORATION MATERIAL:
 1 Steel 3 Stainless steel 5 Fiberglass 7 PVC 10 Asbestos-cement
 2 Brass 4 Galvanized steel 6 Concrete tile 8 RMP (SR) 11 Other (specify)
 12 None used (open hole)
 SCREEN OR PERFORATION OPENINGS ARE:
 1 Continuous slot 3 Mill slot 5 Gauzed wrapped 8 Saw cut 11 None (open hole)
 2 Louvered shutter 4 Key punched 6 Wire wrapped 9 Drilled holes
 7 Torch cut 10 Other (specify)
 SCREEN-PERFORATED INTERVALS: From 280 ft. to 320 ft., From ft. to ft.
 From ft. to ft., From ft. to ft.
 GRAVEL PACK INTERVALS: From 24 ft. to 225 ft., From 240 ft. to 320 ft.
 From ft. to ft., From ft. to ft.

6 GROUT MATERIAL: 1 Neat cement 2 Cement grout 3 Bentonite 4 Other
 Grout Intervals: From 4 ft. to 24 ft., From 225 ft. to 240 ft., From ft. to ft.
 What is the nearest source of possible contamination:
 1 Septic tank 4 Lateral lines 7 Pit privy 10 Livestock pens 14 Abandoned water well
 2 Sewer lines 5 Cess pool 8 Sewage lagoon 11 Fuel storage 15 Oil well/Gas well
 3 Watertight sewer lines 6 Seepage pit 9 Feedyard 12 Fertilizer storage 16 Other (specify below)
 13 Insecticide storage
 Direction from well? Southeast How many feet? 100'

FROM	TO	LITHOLOGIC LOG	FROM	TO	PLUGGING INTERVALS
0	2	Sandy Topsoil			
2	30	Course sand			
30	32	Brown sandy clay			
32	50	Course sand			
50	60	Brown sandy clay			
60	110	Med. sand & brown sandy clay layers			
110	114	Brown sandy clay			
114	126	Brown clay			
126	178	Med. sand & brown sandy clay layers			
178	222	Med. sand & brown sandy clay & sandrock ledges			
222	255	Brown clay			
255	290	Med. sand & white clay layers			
290	318	Med. sand			
318	328	white clay			
328	360	med. sand			

7 CONTRACTOR'S OR LANDOWNER'S CERTIFICATION: This water well was (1) constructed (2) reconstructed, or (3) plugged under my jurisdiction and was completed on (mo/day/year) 6-17-97 and this record is true to the best of my knowledge and belief. Kansas Water Well Contractor's License No. 533 This Water Well Record was completed on (mo/day/yr) 9-22-97 under the business name of Jantzen Water Well Repair by (signature) [Signature]

INSTRUCTIONS: Use typewriter or ball point pen. PLEASE PRESS FIRMLY and PRINT clearly. Please fill in blanks, underline or circle the correct answers, send top three copies to Kansas Department of Health and Environment, Bureau of Water, Topeka, Kansas 66620-0001. Telephone: 913-296-5545. Send one to WATER WELL OWNER and retain one for your records.

OFFICE USE ONLY
T
R
EAW
SEC.
1/4
1/4
1/4