


USE TYPEWRITER OR BALL POINT PEN—PRESS FIRMLY, PRINT CLEARLY.

WATER WELL RECORD
KSA 82a-1201-1215

Kansas Department of Health and Environment—Division of Environment
(Water well Contractors)
Topeka, Kansas 66620

1. Location of well:		County KEARNY	Fraction SE 1/4 NW 1/4 SE 1/4	Section number 3	Township number T 25 S R 35	Range number 35
2. Distance and direction from nearest town or city: bridge at Deerfield follow black top approx. miles 3/4 south 3/4 east		3. Owner of well: Triple T Farms (Circle #3-4) Lakin, Ks 67860		City, state, zip code: Lakin, Ks 67860		
4. Locate with "X" in section below:		Sketch map:		6. Bore hole dia. <u>26</u> in. Completion date <u>11-30-75</u> Well depth <u>320</u> ft.		
				7. <input type="checkbox"/> Cable tool <input type="checkbox"/> Rotary <input type="checkbox"/> Driven <input checked="" type="checkbox"/> Dug <input type="checkbox"/> Hollow rod <input type="checkbox"/> Jetted <input type="checkbox"/> Bored <input type="checkbox"/> Reverse rotary		
5. Type and color of material		From	To	8. Use: <input checked="" type="checkbox"/> Domestic <input type="checkbox"/> Public supply <input type="checkbox"/> Industry <input type="checkbox"/> Irrigation <input type="checkbox"/> Air conditioning <input type="checkbox"/> Stock <input type="checkbox"/> Lawn <input type="checkbox"/> Oil field water <input type="checkbox"/> Other		
				9. Casing: Material <u>steel</u> Height: <u>Above</u> or <u>Below</u> Threaded <input type="checkbox"/> Welded <input checked="" type="checkbox"/> Surface <u>12</u> in. RMP <input type="checkbox"/> PVC <input type="checkbox"/> Weight <u>35.87</u> lbs./ft. Dia. <u>16</u> in. to <u>321</u> ft. depth Wall Thickness: inches or Dia. <u> </u> in. to <u> </u> ft. depth gage No. <u>219 MNC</u>		
				10. Screen: Manufacturer's name <u>Johnson Division</u> Type <u>Galv.</u> Dia. <u>16"</u> Slot/gauze <u>100</u> Length <u>20"</u> Set between <u>210</u> ft. and <u>260</u> ft. Perf. <u>100-210</u> ft. and <u>280-320</u> ft. Gravel pack? <input checked="" type="checkbox"/> yes Size range of material <u>1/2" Down</u>		
				11. Static water level: <u>62</u> ft. below land surface Date <u>12-9-75</u> mo./day/yr.		
				12. Pumping level below land surfaces: <u>86</u> ft. after <u>3</u> hrs. pumping <u>125</u> g.p.m. <u> </u> ft. after <u> </u> hrs. pumping <u> </u> g.p.m. Estimated maximum yield <u>1254</u> g.p.m.		
				13. Water sample submitted: <u> </u> mo./day/yr. Yes <input checked="" type="checkbox"/> No <input type="checkbox"/> Date <u> </u>		
				14. Well head completion: <input type="checkbox"/> Pitless adapter <u>12</u> Inches above grade		
				15. Well grouted? <u>yes</u> With: <input type="checkbox"/> Neat cement <input type="checkbox"/> Bentonite <input checked="" type="checkbox"/> Concrete Depth: From <u>0</u> ft. to <u>10</u> ft.		
				16. Nearest source of possible contamination: <u>N/A</u> ft. <u> </u> Direction <u> </u> Type <input checked="" type="checkbox"/> Well disinfected upon completion? <input type="checkbox"/> Yes <input type="checkbox"/> No		
				17. Pump: <u>Not installed</u> Manufacturer's name <u>Goulds US Pumps</u> Model number <u>K2153</u> HP <u>100</u> Volts <u> </u> Length of drop pipe <u>160</u> ft. capacity <u>1200</u> g.p.m. Type: <input type="checkbox"/> Submersible <input checked="" type="checkbox"/> Turbine <input type="checkbox"/> Jet <input type="checkbox"/> Reciprocating <input type="checkbox"/> Centrifugal <input type="checkbox"/> Other		
18. Elevation:		19. Remarks:				
Topography: <input type="checkbox"/> Hill <input type="checkbox"/> Slope <input type="checkbox"/> Upland <input type="checkbox"/> Valley		(Use a second sheet if needed)				
		20. Water well contractor's certification: This well was drilled under my jurisdiction and this report is true to the best of my knowledge and belief. <u>Walter Wilson Drilling 208</u> Business Office, Box A Garden City, Mo. Address <u> </u> Signed <u>Gene DeDecker</u> Date <u>8-3-76</u> Authorized representative				

T 25 S R 35 E
 Sec 3
 SE 1/4 NW 1/4 SE 1/4

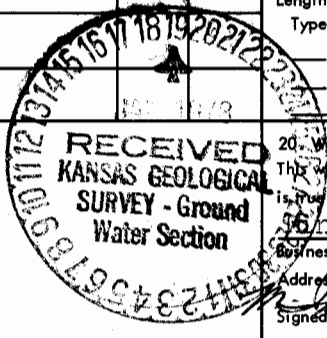

Forward the white, blue and pink copies to the Department of Health and Environment

Form WWC-5

The Professionals

MINTER-WILSON DRILLING CO.

INCORPORATED

Irrigation
and Domestic
Water Systems
Complete Installation
and Repairing

Phone 276-8269 • P.O. Box 493 • GARDEN CITY, KANSAS 67846

Triple T. Farms
Kearny County
10-15-75

Location: SE 3-25-35
Circle 3-4

Pivot

0	17	Fine Sand
17	43	Med. To Coarse Gravel (Loose)
43	53	Brown Clay
53	104	Fine to Med. Sand & Gravel (Loose)
104	112	Brown Clay
112	125	Brown & Blue Clay
125	140	Fine to Med. Sand & Gravel (Loose)
140	153	Brown Sandy Clay, Streaks of Gravel, 30%
153	173	Fine to Med. Sand & Gravel, 10% Clay (Loose)
173	198	Blue Clay
198	221	Fine to Med. Sand & Gravel (Loose)
221	230	Brown Clay
230	258	Fine to Med. Sand & Gravel (Loose)
258	273	Brown Sandy Clay
273	290	Fine to Med. Sand & Fine Gravel, 10% Clay (Loose)
290	320	Fine to Med. Sand & Gravel, 10% Clay (Loose)
320	350	Brown Sandy Clay
350	362	Fine to Med. Sand & Gravel, 20% Clay (Loose)
362	371	Brown Sandy Clay
371	380	Brown, Gray & Yellow Clay with Brown Rock (Hard)

TD 320'