

USE TYPEWRITER OR BALL POINT PEN—PRESS FIRMLY, PRINT CLEARLY.


T R EW sec 1/4 1/4 1/4 No.

WATER WELL RECORD
KSA 82a-1201-1215

Kansas State Dept. Of Health
(Water Well Contractors)
Forbes-Bldg. 740
Topeka, Kansas 66620

1 Location of well:	County Kearny	Township name Southside	Fraction SE of NW¹/₄	Section number 5	Town number T S 25	Range number R W 35
---------------------	-------------------------	-----------------------------------	--	----------------------------	------------------------------	-------------------------------

Distance and direction from nearest town or city: 4 miles south Street address of well location if in city: 3 miles west of Deerfield, Ks.	3 Owner of well: L.F. Roderick Address: Garden City, Ks. 67846
---	---

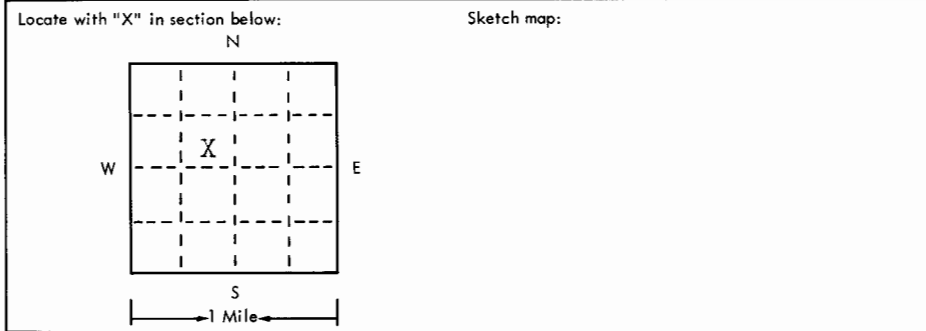

4 Well depth: 275 ft. Date of completion 1-11-75
Well diameter: 26 in.

5 Cable tool Rotary Driven Dug
 Hollow rod Jetted Bored Reverse rotary

6 Use: Domestic Public supply Industry
 Irrigation Air conditioning Commercial
 Test well

7 Casing: Material St. Height: above/below
Threaded Welded Surface 12 in.
Diam. 16 in. to 276 ft. depth Drive shoe? Yes No
Weight 34.25 lb./ft. 1

2 Type and color of material	From	To
Clay & Sand	0	3
Medium to Coarse Gravel	3	37
Brown Clay	37	65
Brown Clay with Streaks of Gravel 20%	65	80
Fine to Medium Sand & Gravel (Loose)	80	96
Brown Sandy Clay with streaks of Gravel 30%	96	125
Fine to Medium Sand & Gravel 10% Clay (Loose)	125	140
Brown Sandy Clay & Brown Clay	140	153
Fine to Medium Sand & Gravel (Loose)	153	214
Brown Sandy Clay with streaks of Fine to Medium Sand	214	230
Fine to Medium Sand & Fine Gravel (Loose)	230	243
Fine to Medium Sand & Gravel (Loose)	243	275
Fine to Medium Sand & Gravel 20% Clay (Loose)	275	290
Brown, Gray & Yellow Clay (Hard)	290	305
(use a second sheet if needed)		

8 Screen: **No screen used**
Manufacturer _____
Type _____ Dia. _____
Slot/gauze _____ Length _____
Set between _____ ft. and _____ ft. _____
Perforations: 80-195
Gravel pack Yes No Size range of material 1/2" down

9 Static water level: 31 ft. below land surface Date 1-12-75

10 Pumping level below land surfaces: 726
37 ft. after 2 hrs. pumping 1360 g.p.m.
47 ft. after 4 hrs. pumping 1360 g.p.m.
Estimated maximum yield 1200 g.p.m.

11 Water sample submitted:
 Yes No Date _____

12 Well head completion:
 Pitless adapter 12 Inches above grade

13 Well grouted? Yes No
 Neat cement Bentonite Clay Puddled
Depth: From 0 ft. to 10 ft.

14 Nearest source of possible contamination: N/A
ft. _____ Direction _____ Type _____
Well disinfected upon completion? Yes No

15 Pump: Not installed
Manufacturer's name FMC-Peerless
Model number 3031 HP 100 Volts _____
Length of drop pipe 140 ft. capacity 800 g.p.m.
Type:
 Submersible Turbine
 Jet Reciprocating
 Centrifugal Other

16 Remarks: elevation **Good Well! Customer well satisfied.**
No possible contamination

Topography:
 Hill
 Slope
 Upland
 Valley

17 Water well contractor's certification:
This well was drilled under my jurisdiction and this report is true to the best of my knowledge and belief.
Minter-Wilson Drlg. Co. 208
Business name _____ License No. _____
Address Box 493 Garden City, Ks.
Signed [Signature] Date 3/15/75
Authorized representative