


1 LOCATION OF WATER WELL: Fraction 1/4 N 2 1/4 SW 1/4 Section Number 5 Township Number T 25 S Range Number R 35 EW County: Kearny

Distance and direction from nearest town or city street address of well if located within city? Deerfield 4 South 1 West 2 1/2 South 300' East 80' South

2 WATER WELL OWNER: Triple T. Farms RR#, St. Address, Box #: P. O. Box 69 City, State, ZIP Code: Lakin, Kansas 67860 Board of Agriculture, Division of Water Resources Application Number:

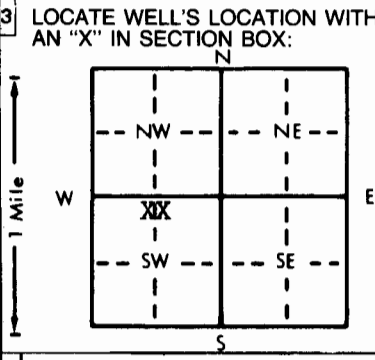

3 LOCATE WELL'S LOCATION WITH AN 'X' IN SECTION BOX: 4 DEPTH OF COMPLETED WELL: 330 ft. ELEVATION: WELL'S STATIC WATER LEVEL: 115 ft. below land surface measured on mo/day/yr 8-8-85

5 TYPE OF BLANK CASING USED: 1 Steel, 3 RMP (SR), 2 PVC, 4 ABS. CASING JOINTS: Glued, Clamped, Welded, Threaded. Blank casing diameter: 8-5/8 in. to 160 ft., Dia. 8-5/8 in. to 210-300 ft., Dia. Casing height above land surface: 12 in., weight 16.90 lbs./ft. Wall thickness or gauge No. 188.

6 GROUT MATERIAL: 1 Neat cement, 2 Cement grout, 3 Bentonite, 4 Other. Grout intervals: From 5 ft. to 15 ft. What is the nearest source of possible contamination: 1 Septic tank, 4 Lateral lines, 7 Pit privy, 10 Livestock pens, 14 Abandoned water well

Table with columns: FROM, TO, LITHOLOGIC LOG. Content: Test Log Attached

7 CONTRACTOR'S OR LANDOWNER'S CERTIFICATION: This water well was (1) constructed, (2) reconstructed, or (3) plugged under my jurisdiction and was completed on (mo/day/year) 9-12-85 and this record is true to the best of my knowledge and belief. Kansas Water Well Contractor's License No. 208 This Water Well Record was completed on (mo/day/yr) 9-20-85 under the business name of Minter-Wilson Drilling Company by (signature) Nora Keller

INSTRUCTIONS: Use typewriter or ball point pen, PLEASE PRESS FIRMLY and PRINT clearly. Please fill in blanks, underline or circle the correct answers. Send top three copies to Kansas Department of Health and Environment, Division of Environment, Environmental Geology Section, Topeka, KS 66620. Send one to WATER WELL OWNER and retain one for your records.

Triple T Farms
Kearny County
8-8-1985

Location:

Deerfield River Road to Tate Line
2½ S. 300' E. 80' S.

Static Water Level 115

Test #1

| | | |
|-----|-----|---|
| 0 | 65 | Top Soil |
| 65 | 71 | Brown sandy clay |
| 71 | 80 | Fine to medium sand and gravel |
| 80 | 112 | Brown sandy clay |
| 112 | 119 | Fine to medium sand and gravel |
| 119 | 147 | Brown sandy clay |
| 147 | 178 | Blue clay |
| 178 | 190 | Brown sandy clay, small streak of gravel |
| 190 | 213 | Fine to medium sand and gravel |
| 213 | 231 | Brown sandy clay |
| 231 | 236 | Fine to medium sand and gravel |
| 236 | 245 | Brown sandy clay |
| 245 | 270 | Brown sandy clay, sticky tight |
| 270 | 302 | Brown sandy clay, white rock mixed (hard) |
| 302 | 312 | Brown sandy clay, small gravel streak |
| 312 | 334 | Brown sandy clay, small gravel streak |
| 334 | 355 | Brown sandy clay, tight |
| 355 | 362 | Yellow clay |