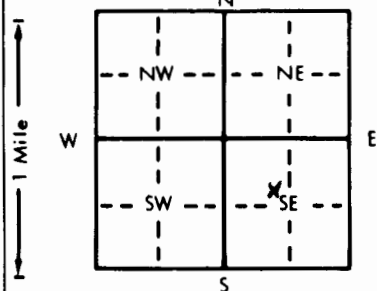


1 LOCATION OF WATER WELL:	Fraction	Section Number	Township Number	Range Number
County: <u>Kearny</u>	<u>SE 1/4 NW 1/4 SE 1/4</u>	<u>13</u>	<u>T 25 S</u>	<u>R 35 E</u>

Distance and direction from nearest town or city street address of well if located within city?

2 WATER WELL OWNER:	Brad Tate	Sweetman Drilling Company
RR#, St. Address, Box # :	101 North Main	Board of Agriculture, Division of Water Resources
City, State, ZIP Code :	Lakin, KS 67860	Application Number: 900071

3 LOCATE WELL'S LOCATION WITH AN "X" IN SECTION BOX:	4 DEPTH OF COMPLETED WELL: <u>300</u> ft. ELEVATION:
	WELL'S STATIC WATER LEVEL <u>140</u> ft. below land surface measured on mo/day/yr <u>02-04-90</u>
	WELL WATER TO BE USED AS:
	1 Domestic 3 Feedlot <u>6 Oil field water supply</u> 9 Dewatering 11 Injection well
	2 Irrigation 4 Industrial 7 Lawn and garden only 10 Monitoring well 12 Other (Specify below)
	Was a chemical/bacteriological sample submitted to Department? Yes <u>No</u> <u>X</u> ; If yes, mo/day/yr sample was submitted
	Water Well Disinfected? Yes <u>X</u> No

5 TYPE OF BLANK CASING USED:	5 Wrought iron	8 Concrete tile	CASING JOINTS: Glued <u>X</u> Clamped
1 Steel	3 RMP (SR)	6 Asbestos-Cement	9 Other (specify below)
<u>2 PVC</u>	4 ABS	7 Fiberglass	Welded
Blank casing diameter <u>5 1/2</u> in. to <u>240</u> ft. Dia			Threaded
Casing height above land surface <u>30</u> in., weight <u>2.93</u> lbs./ft. Wall thickness or gauge No. <u>265</u>			
TYPE OF SCREEN OR PERFORATION MATERIAL:			
1 Steel	3 Stainless steel	5 Fiberglass	8 RMP (SR)
2 Brass	4 Galvanized steel	6 Concrete tile	9 ABS
SCREEN OR PERFORATION OPENINGS ARE:			
1 Continuous slot	3 Mill slot	5 Gauzed wrapped	8 Saw cut
2 Louvered shutter	4 Key punched	6 Wire wrapped	9 Drilled holes
SCREEN-PERFORATED INTERVALS:			
From <u>240</u> ft. to <u>300</u> ft.			
GRAVEL PACK INTERVALS:			
From <u>240</u> ft. to <u>300</u> ft.			

6 GROUT MATERIAL:	1 Neat cement	2 Cement grout	3 Bentonite	4 Other
Grout Intervals: From <u>240</u> ft. to <u>300</u> ft.				
What is the nearest source of possible contamination:				
1 Septic tank	4 Lateral lines	7 Pit privy	10 Livestock pens	14 Abandoned water well
2 Sewer lines	5 Cess pool	8 Sewage lagoon	11 Fuel storage	<u>15 Oil well/Gas well</u>
3 Watertight sewer lines	6 Seepage pit	9 Feedyard	12 Fertilizer storage	16 Other (specify below)
Direction from well? <u>Northwest</u>			How many feet? <u>170</u>	

FROM	TO	LITHOLOGIC LOG	FROM	TO	PLUGGING INTERVALS
0	8	Topsoil			
8	53	Gravel			
53	68	Clay			
68	102	Sand			
102	117	White Clay			
117	149	Med. Sand & Gravel			
149	156	Clay			
156	168	Sand			
168	203	Clay			
203	211	Fine Sand			
211	234	Clay			
234	254	Sand & Gravel			
254	260	Clay			
260	274	Gravel			
274	292	Brown Clay			
		292-300 Sand			

7 CONTRACTOR'S OR LANDOWNER'S CERTIFICATION: This water well was <u>(1) constructed</u> , (2) reconstructed, or (3) plugged under my jurisdiction and was completed on (mo/day/year) <u>02-04-90</u> and this record is true to the best of my knowledge and belief. Kansas Water Well Contractor's License No. <u>430</u> This Water Well Record was completed on (mo/day/yr) <u>02-26-90</u> under the business name of <u>Howard Drilling Company</u> by (signature) <u>Howard Drilling Company</u>
--

INSTRUCTIONS: Use typewriter or ball point pen. PLEASE PRESS FIRMLY and PRINT clearly. Please fill in blanks, underline or circle the correct answers. Send top three copies to Kansas Department of Health and Environment, Bureau of Water Protection, Topeka, Kansas 66620-7320. Telephone: 913-296-5514. Send one to WATER WELL OWNER and retain one for your records.