


1 LOCATION OF WATER WELL:	Fraction	Section Number	Township Number	Range Number
County: Kearny	NE ¼ NE ¼ SW ¼	24	T 25 S	R 35 EW

Distance and direction from nearest town or city street address of well if located within city? 1 Mile North of Plymell, 8 Miles West on Blacktop, 6 Miles North, 2½ Miles West on gravel road, 1 Mile North, ½ Mile East into

2 WATER WELL OWNER: McCoy Petroleum  
 RR#, St. Address, Box #: 110 South Main Suite #500 Board of Agriculture, Division of Water Resources  
 City, State, ZIP Code: Wichita, Kansas 67202 Application Number: T87-561

3 LOCATE WELL'S LOCATION WITH AN "X" IN SECTION BOX:

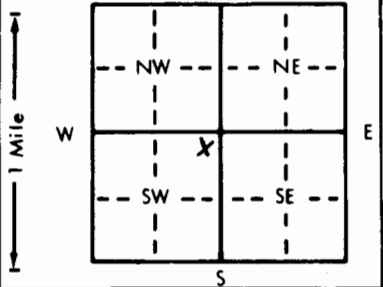

4 DEPTH OF COMPLETED WELL: 340 ft. ELEVATION: \_\_\_\_\_

Depth(s) Groundwater Encountered 1. \_\_\_\_\_ ft. 2. \_\_\_\_\_ ft. 3. \_\_\_\_\_ ft.

WELL'S STATIC WATER LEVEL: 150 ft. below land surface measured on mo/day/yr

Pump test data: Well water was \_\_\_\_\_ ft. after \_\_\_\_\_ hours pumping \_\_\_\_\_ gpm

Est. Yield \_\_\_\_\_ gpm: Well water was \_\_\_\_\_ ft. after \_\_\_\_\_ hours pumping \_\_\_\_\_ gpm

Bore Hole Diameter: 11 in. to 340 ft., and \_\_\_\_\_ in. to \_\_\_\_\_ ft.

WELL WATER TO BE USED AS:

5 Public water supply	8 Air conditioning	11 Injection well
6 Oil field water supply	9 Dewatering	12 Other (Specify below)
7 Lawn and garden only	10 Monitoring well	

1 Domestic 3 Feedlot 2 Irrigation 4 Industrial

Was a chemical/bacteriological sample submitted to Department? Yes \_\_\_\_\_ No \_\_\_\_\_; If yes, mo/day/yr sample was submitted \_\_\_\_\_

Water Well Disinfected? Yes \_\_\_\_\_ No \_\_\_\_\_

5 TYPE OF BLANK CASING USED:

1 Steel	3 RMP (SR)	5 Wrought iron	8 Concrete tile	CASING JOINTS: Glued _____ Clamped _____
2 PVC	4 ABS	6 Asbestos-Cement	9 Other (specify below)	Welded _____
		7 Fiberglass		Threaded _____

Blank casing diameter: 6 3/8 in. to \_\_\_\_\_ ft., Dia \_\_\_\_\_ in. to \_\_\_\_\_ ft., Dia \_\_\_\_\_ in. to \_\_\_\_\_ ft.

Casing height above land surface: -60 in., weight: 3.71 lbs./ft. Wall thickness or gauge No. -280

TYPE OF SCREEN OR PERFORATION MATERIAL:

1 Steel	3 Stainless steel	5 Fiberglass	8 RMP (SR)	11 Other (specify)
2 Brass	4 Galvanized steel	6 Concrete tile	9 ABS	12 None used (open hole)

SCREEN OR PERFORATION OPENINGS ARE:

1 Continuous slot	3 Mill slot	5 Gauzed wrapped	8 Saw cut	11 None (open hole)
2 Louvered shutter	4 Key punched	6 Wire wrapped	9 Drilled holes	
		7 Torch cut	10 Other (specify)	

SCREEN-PERFORATED INTERVALS: From \_\_\_\_\_ ft. to \_\_\_\_\_ ft., From \_\_\_\_\_ ft. to \_\_\_\_\_ ft., From \_\_\_\_\_ ft. to \_\_\_\_\_ ft.

GRAVEL PACK INTERVALS: From 27 ft. to 150 ft., From 160 ft. to 340 ft.

6 GROUT MATERIAL: 1 Neat cement 2 Cement grout 3 Bentonite 4 Other

Grout Intervals: From 5 ft. to 7 ft., From 7 ft. to 27 ft., From 150 ft. to 160 ft.

What is the nearest source of possible contamination:

1 Septic tank	4 Lateral lines	7 Pit privy	10 Livestock pens	14 Abandoned water well
2 Sewer lines	5 Cess pool	8 Sewage lagoon	11 Fuel storage	15 Oil well/Gas well
3 Watertight sewer lines	6 Seepage pit	9 Feedyard	12 Fertilizer storage	16 Other (specify below)
			13 Insecticide storage	

Direction from well? Southeast How many feet? 330'

FROM	TO	LITHOLOGIC LOG	FROM	TO	PLUGGING INTERVALS
			0	5	Backfill
			5	7	Neat Cement
			7	27	Bentonite Grout
			27	150	Chlorinated Gravel
			150	160	Bentonite Grout
			160	340	Chlorinated Gravel
					Dug up well casing to 5', capped, cemented over, then backfilled.

7 CONTRACTOR'S OR LANDOWNER'S CERTIFICATION: This water well was (1) constructed, (2) reconstructed, or (3) plugged under my jurisdiction and was completed on (mo/day/year) 01-15-90 and this record is true to the best of my knowledge and belief. Kansas Water Well Contractor's License No. 430 This Water Well Record was completed on (mo/day/yr) 01-18-90 under the business name of Howard Drilling Company by (signature) \_\_\_\_\_