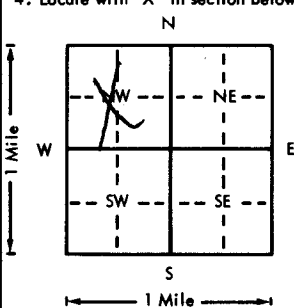


USE TYPEWRITER OR BALL POINT PEN-PRESS FIRMLY, PRINT CLEARLY.

WATER WELL RECORD
KSA 82a-1201-1215

Kansas Department of Health and Environment-Division of Environment
(Water well Contractors)
Topeka, Kansas 66620

1. Location of well:	County KEARNY	Fraction NE SW NW 1/4 SE 1/4 NW 1/4	Section number 29	Township number T 5 S	Range number R 35 W
2. Distance and direction from nearest town or city: From Lakin 1 south 2 1/2 east 5 south 1 1/4 east 3/4 north Street address of well location if in city:			3. Owner of well: Wayne Thornbrough R.R. or street: 45 Laurie St. City, state, zip code: Concord, Mass. 01742		
4. Locate with "X" in section below: 			Sketch map:		
5. Type and color of material			From	To	6. Bore hole dia. 26 in. Completion date 4-30-76 Well depth 370 ft.
					7. <input type="checkbox"/> Cable tool <input type="checkbox"/> Rotary <input type="checkbox"/> Driven <input type="checkbox"/> Dug <input type="checkbox"/> Hollow rod <input type="checkbox"/> Jetted <input type="checkbox"/> Bored <input checked="" type="checkbox"/> Reverse rotary
					8. Use: <input type="checkbox"/> Domestic <input type="checkbox"/> Public supply <input type="checkbox"/> Industry <input checked="" type="checkbox"/> Irrigation <input type="checkbox"/> Air conditioning <input type="checkbox"/> Stock <input type="checkbox"/> Lawn <input type="checkbox"/> Oil field water <input type="checkbox"/> Other
					9. Casing: Material steel Height: Above or below Threaded <input type="checkbox"/> Welded <input checked="" type="checkbox"/> Surface 12 in. RMP <input type="checkbox"/> PVC <input type="checkbox"/> Weight 36.87 lbs./ft. Dia. 16 n. to 371 ft. depth Wall Thickness: inches or Dia. <input type="checkbox"/> in. to <input type="checkbox"/> ft. depth gage No. <input type="checkbox"/>
					10. Johnson Division Type Galv. Dia. 16" Slot/gauze 100 Length 20' Set between 290-300 ft. and 330-340 ft. Peri. 120-290 ft. and 300-330-340-370 ft. Gravel pack? <input checked="" type="checkbox"/> yes Size range of material 1/2" Down
					11. Static water level: <input type="checkbox"/> mo./day/yr. 79 ft. below land surface Date 4-22-76
					12. Pumping level below land surfaces: 94 ft. after 3 hrs. pumping 1450 g.p.m. <input type="checkbox"/> ft. after <input type="checkbox"/> hrs. pumping <input type="checkbox"/> g.p.m. Estimated maximum yield 1450 g.p.m.
					13. Water sample submitted: <input type="checkbox"/> mo./day/yr. <input type="checkbox"/> Yes <input checked="" type="checkbox"/> No Date <input type="checkbox"/>
					14. Well head completion: <input type="checkbox"/> Pitless adapter <input checked="" type="checkbox"/> 12 inches above grade
					15. Well grouted? <input checked="" type="checkbox"/> yes With: <input type="checkbox"/> Neat cement <input type="checkbox"/> Bentonite <input checked="" type="checkbox"/> Concrete Depth: From 0 ft. to 10 ft.
					16. Nearest source of possible contamination: N/A ft. <input type="checkbox"/> Direction <input type="checkbox"/> Type <input type="checkbox"/> Well disinfected upon completion? <input type="checkbox"/> Yes <input checked="" type="checkbox"/> No
					17. Pump: <input type="checkbox"/> Not installed Manufacturer's name FMC Peerless Model number 121B HP 100 Volts <input type="checkbox"/> Length of drop pipe 160 ft. capacity 1000 p.m. Type: <input type="checkbox"/> Submersible <input checked="" type="checkbox"/> Turbine <input type="checkbox"/> Jet <input type="checkbox"/> Reciprocating <input type="checkbox"/> Centrifugal <input type="checkbox"/> Other
			(Use a second sheet if needed)		
18. Elevation:	19. Remarks:		20. Water well contractor's certification: This well was drilled under my jurisdiction and this report is true to the best of my knowledge and belief. Minter Wilson Drilling 208 Business name P.O. Box A Garden City, KS Address _____ Signature Minter Wilson Date 8-12-76 Authorized representative		
Topography: <input type="checkbox"/> Hill <input checked="" type="checkbox"/> Slope <input type="checkbox"/> Upland <input type="checkbox"/> Valley					

25 350 29 NE SW NW 1/4 1/4 1/4

Forward the white, blue and pink copies to the Department of Health and Environment

Form WWC-5

Phone 276-8269

WEN CITY, KANSAS 67846

LOCATION: NW 29-25-35 (Campbell Tennant)
30 Feet West of Pivot

TEST C-6

- 0 25 Fine Sand
25 30 Brown Clay
30 77 Fine To Med. Sand & Gravel (Loose)
77 80 Brown Sandy Clay
80 96 Fine To Med. Sand, Streaks Of Clay (20%)
96 108 Fine To Med. Sand, Streaks Of Clay (10%)
108 110 Brown Sandy Clay
110 200 Fine To Med. Sand & Gravel (Loose)
200 208 Fine To Med. Sand & Gravel, Streaks Of Clay (10%)
208 268 Fine To Med. Sand & Gravel (Loose)
268 283 Fine To Med. Sand & Gravel (Small Hard Streaks)
283 290 Fine To Med. Sand & Gravel, Streak Of Clay (10%)
290 306 Fine To Med. Sand & Gravel (Loose)
306 330 Brown Sandy Clay
330 341 Fine To Med. Sand (Loose)
341 350 Fine To Med. Sand, Streak Of Clay (10%) (Loose)
350 361 Fine To Med. Sand, Streak Of Clay (10%) (Loose)
361 370 Fine To Med. Sand & Fine Gravel (Loose)
370 383 Brown Sandy Clay
383 390 Brown & Yellow Clay (Hard) Used Pull Down