


1 LOCATION OF WATER WELL: Fraction Section Number Township Number Range Number
 COUNTY: 047 KEARNY SE 1/4 SE 1/4 NW 1/4 25 T 25 S R 35 W

Distance and direction from nearest town or city street address of well if located within city?
 APPROX. 8 MILES SOUTH AND 3/4 EAST OF DEERFIELD

2 WATER WELL OWNER: PREMIER ALFALFA
 RR#, St. Address, Box # : PO BOX 518 Board of Agriculture, Division of Water Resources
 City, State, ZIP code : HUGOTON, KS 67951-0518 Application Number:

3 LOCATE WELL'S LOCATION WITH AN "X" IN SECTION BOX:

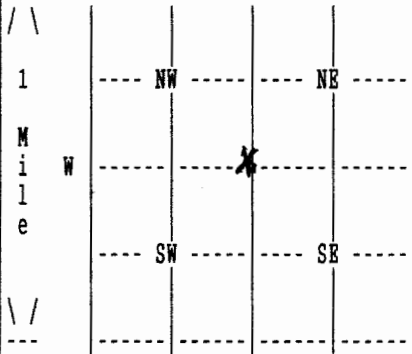

4 DEPTH OF COMPLETED WELL 275 ELEVATION: 0
 Depth(s) Groundwater Encountered 1. 0 ft. 2. 0 ft. 3. 0 ft.

WELL'S STATIC WATER LEVEL 225 ft. below land surface measured on mo/day/yr 7/02/04
 Pump test data: Well water was 0 ft. after 0 hours pumping 0 gpm

Estimated Yield 0 gpm: Well water was 0 ft. after 0 hours pumping 0 gpm

Bore Hole Diameter in. to 0 ft., and in. to 0 ft.

WELL WATER WAS: 01 DOMESTIC

Was a chemical/bacteriological sample submitted to department? No ;
 If yes, mo/day/yr sample was submitted Water well disinfected? Yes

5 TYPE OF BLANK CASING USED: 02 PVC CASING JOINTS: GLUED
 Blank casing diameter 5 in. to 275 ft., Dia in. to 0 ft., Dia in. to 0 ft.
 Casing height above land surface -48 in., weight 0 lbs/ft. Wall thickness or gauge No.
 TYPE OF SCREEN OR PERFORATION MATERIAL: 07 PVC
 SCREEN OR PERFORATION OPENINGS ARE: UNKNOWN

SCREEN PERFORATED INTERVALS: From 0 ft. to 0 ft., From 0 ft. to 0 ft.
 From 0 ft. to 0 ft., From 0 ft. to 0 ft.
 GRAVEL PACK INTERVALS: From 0 ft. to 0 ft., From 0 ft. to 0 ft.
 From 0 ft. to 0 ft., From 0 ft. to 0 ft.

6 GROUT MATERIAL 02 CEMENT GROUT
 Grout Intervals: From 4 ft. to 275 ft., From 0 ft. to 0 ft., From 0 ft. to 0 ft.
 What is the nearest source of possible contamination: WATER WELL
 Direction from well? EAST How many feet? 60

| FROM | TO | LITHOLOGIC LOG | FROM | TO | PLUGGING INTERVALS |
|------|----|----------------|------|-----|--------------------|
| | | | 0 | 4 | BACKFILL |
| | | | 4 | 275 | CEMENT |
| | | | 0 | 0 | |
| | | | 0 | 0 | |
| | | | 0 | 0 | |
| | | | 0 | 0 | |
| | | | 0 | 0 | |
| | | | 0 | 0 | |
| | | | 0 | 0 | |

7 CONTRACTOR'S OR LANDOWNER'S CERTIFICATION: This water well was Plugged under my jurisdiction and was completed on (mo/day/year) 07/02/04 and this record is true to the best of my knowledge and belief. Kansas Water Well Contractor's License No. 145 This Water Well Record was completed on (mo/day/yr) 09/28/04 under the business name of HENKLE DRILLING & SUPPLY by (signature) *Benjamin Reichert*