

WATER WELL RECORD Form WWC-5 KSA 82a-1212


1 LOCATION OF WATER WELL: Fraction | Section Number | Township Number | Range Number
 COUNTY: 047 KEARNY | SE 1/4 SE 1/4 NE 1/4 | 06 | T 25 S | R 35 W

Distance and direction from nearest town or city street address of well if located within city?
 FROM LAKIN; APPX 1 MILE SOUTH & 2 3/4 MILES EAST

2 WATER WELL OWNER: MID STATES HAY
 RR#, St. Address, Box #: PO BOX 1090 Board of Agriculture, Division of Water Resources
 City, State, ZIP code: LAKIN, KS 67860-1090 Application Number:

3 LOCATE WELL'S LOCATION WITH AN "X" IN SECTION BOX:

4 DEPTH OF COMPLETED WELL 96 ELEVATION: 0
 Depth(s) Groundwater Encountered 1. 0 ft. 2. 0 ft. 3. 0 ft.

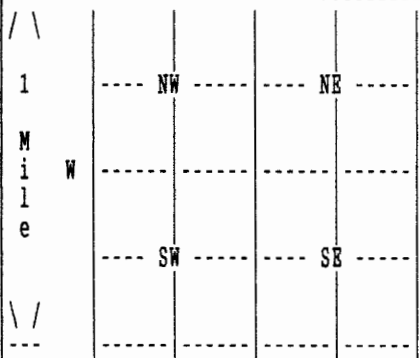

WELL'S STATIC WATER LEVEL 0 ft. below land surface measured on mo/day/yr
 Pump test data: Well water was 0 ft. after 0 hours pumping 0 gpm

Estimated Yield 0 gpm: Well water was 0 ft. after 0 hours pumping 0 gpm

Bore Hole Diameter 10 in. to 96 ft., and in. to 0 ft.

WELL WATER TO BE USED AS: 01 DOMESTIC

Was a chemical/bacteriological sample submitted to department? No ;
 If yes, mo/day/yr sample was submitted Water well disinfected? Yes

5 TYPE OF BLANK CASING USED: 02 PVC CASING JOINTS: OTHER - CERT - LOCK
 Blank casing diameter 5 in. to 96 ft., Dia in. to 0 ft., Dia in. to 0 ft.
 Casing height above land surface 12 in., weight 3 lbs/ft. Wall thickness or gauge No. .265
 TYPE OF SCREEN OR PERFORATION MATERIAL: 07 PVC
 SCREEN OR PERFORATION OPENINGS ARE: 03 MILL SLOT

SCREEN PERFORATED INTERVALS: From 76 ft. to 96 ft., From 0 ft. to 0 ft.
 From 0 ft. to 0 ft., From 0 ft. to 0 ft.
 GRAVEL PACK INTERVALS: From 25 ft. to 96 ft., From 0 ft. to 0 ft.
 From 0 ft. to 0 ft., From 0 ft. to 0 ft.

6 GROUT MATERIAL 03 BENTONITE
 Grout Intervals: From 5 ft. to 25 ft., From 0 ft. to 0 ft., From 0 ft. to 0 ft.
 What is the nearest source of possible contamination: NONE OBSERVED
 Direction from well? How many feet? 0

FROM	TO	LITHOLOGIC LOG	FROM	TO	PLUGGING INTERVALS
0	2	02 SILT			
2	4	01 CLAY			
4	13	05 SAND 13 FINE GRAVEL 14 MED GRAVEL			
13	37	04 SANDY CLAY			
37	46	07 FINE SAND 08 MEDIUM SAND			
46	58	04 SANDY CLAY			
58	72	05 SAND 01 CLAY			
72	96	05 SAND			
96	98	01 CLAY			

7 CONTRACTOR'S OR LANDOWNER'S CERTIFICATION: This water well was Constructed under my jurisdiction and was completed on (mo/day/year) 03/10/06 and this record is true to the best of my knowledge and belief. Kansas Water Well Contractor's License No. 145 This Water Well Record was completed on (mo/day/yr) 07/07/06 under the business name of HENKLE DRILLING & SUPPLY by (signature)