


WATER WELL RECORD Form WWC-5 KSA 82a-1212

1 LOCATION OF WATER WELL: Fraction Section Number Township Number Range Number
 COUNTY: 047 KEARNY SE 1/4 SE 1/4 NE 1/4 06 T 25 S R 35 W

Distance and direction from nearest town or city street address of well if located within city?
 FROM LAKIN; APPX 1 MILE SOUTH & 2 3/4 MILES EAST

2 WATER WELL OWNER: MID STATES HAY Board of Agriculture, Division of Water Resources
 RR#, St. Address, Box #: PO BOX 1090 Application Number:
 City, State, ZIP code: LAKIN, KS 67860-1090

3 LOCATE WELL'S LOCATION WITH AN "X" IN SECTION BOX:

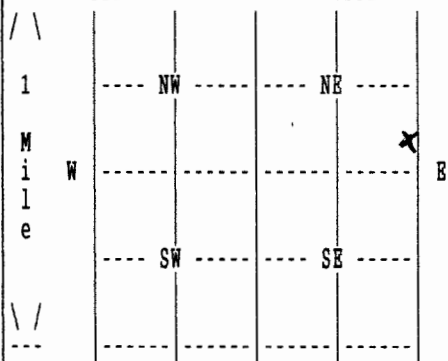

4 DEPTH OF COMPLETED WELL 62 ELEVATION: 0
 Depth(s) Groundwater Encountered 1. 0 ft. 2. 0 ft. 3. 0 ft.

WELL'S STATIC WATER LEVEL 0 ft. below land surface measured on mo/day/yr
 Pump test data: Well water was 0 ft. after 0 hours pumping 0 gpm

Estimated Yield 0 gpm: Well water was 0 ft. after 0 hours pumping 0 gpm

Bore Hole Diameter 10 in. to 62 ft., and in. to 0 ft.

WELL WATER TO BE USED AS: 01 DOMESTIC

Was a chemical/bacteriological sample submitted to department? No ;
 If yes, mo/day/yr sample was submitted Water well disinfected? Yes

5 TYPE OF BLANK CASING USED: 02 PVC CASING JOINTS: OTHER - CERT - LOCK
 Blank casing diameter 5 in. to 62 ft., Dia in. to 0 ft., Dia in. to 0 ft.
 Casing height above land surface 12 in., weight 3 lbs/ft. Wall thickness or gauge No. .265
 TYPE OF SCREEN OR PERFORATION MATERIAL: 07 PVC
 SCREEN OR PERFORATION OPENINGS ARE: 03 MILL SLOT

SCREEN PERFORATED INTERVALS: From 42 ft. to 62 ft., From 0 ft. to 0 ft.
 From 0 ft. to 0 ft., From 0 ft. to 0 ft.
 GRAVEL PACK INTERVALS: From 25 ft. to 62 ft., From 0 ft. to 0 ft.
 From 0 ft. to 0 ft., From 0 ft. to 0 ft.

6 GROUT MATERIAL 03 BENTONITE
 Grout Intervals: From 5 ft. to 25 ft., From 0 ft. to 0 ft., From 0 ft. to 0 ft.
 What is the nearest source of possible contamination: NONE OBSERVED
 Direction from well? How many feet? 0

FROM	TO	LITHOLOGIC LOG	FROM	TO	PLUGGING INTERVALS
0	2	02 SILT			
2	4	01 CLAY			
4	12	05 SAND			
12	35	04 SANDY CLAY			
35	47	05 SAND 13 FINE GRAVEL 01 CLAY			
47	51	04 SANDY CLAY			
51	53	05 SAND			
53	56	04 SANDY CLAY			
56	62	04 SANDY CLAY 05 SAND			

7 CONTRACTOR'S OR LANDOWNER'S CERTIFICATION: This water well was constructed under my jurisdiction and was completed on (mo/day/year) 03/07/06 and this record is true to the best of my knowledge and belief. Kansas Water Well Contractor's License No. 145 This Water Well Record was completed on (mo/day/yr) 07/07/06 under the business name of HENKLE DRILLING & SUPPLY by (signature) *Bruce J. Ruckman*