

**WATER WELL RECORD**

**Form WWC-5**

Division of Water Resources App. No.


24,381

<b>1 LOCATION OF WATER WELL:</b> County: <b>KEARNY</b>	Fraction <b>¼ NE ¼ SE ¼ SW ¼</b>	Section Number <b>31</b>	Township No. <b>T 25 S</b>	Range Number <b>R 35</b> <input type="checkbox"/> E <input checked="" type="checkbox"/> W
---	-------------------------------------	-----------------------------	-------------------------------	--

Street/Rural Address of Well Location; if unknown, distance & direction from nearest town or intersection: If at owner's address, check here .  
**LAKIN-1 M S, 1/4 M. E TO LAKIN LANE, 6 M S, 3 M E, 920 FT. NORTH & 3,250 FT. WEST**

**Global Positioning System (GPS) information:**  
 Latitude: ..... (in decimal degrees)  
 Longitude: ..... (in decimal degrees)  
 Elevation: .....  
 Datum:  WGS 84,  NAD 83,  NAD 27  
 Collection Method:  
 GPS unit (Make/Model: .....)  
 Digital Map/Photo,  Topographic Map,  Land Survey  
 Est. Accuracy:  <3 m,  3-5 m,  5-15 m,  >15 m

**2 WATER WELL OWNER:** **BLUE HOUSE FAMILY TRUST**  
 RR#, Street Address, Box #: **WALTER FLETCHER-DRAWER C**  
 City, State, ZIP Code : **LAKIN, KS 67860**

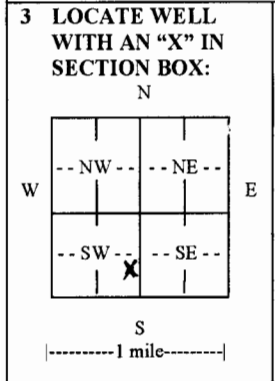

**4 DEPTH OF COMPLETED WELL** **520** ..... ft.  
 Depth(s) Groundwater Encountered (1)..... ft. (2)..... ft. (3)..... ft.  
 WELL'S STATIC WATER LEVEL **200** ..... ft. below land surface measured on mo/day/yr. **6-4-09**  
 Pump test data: Well water was ..... ft. after ..... hours pumping ..... gpm  
 EST. YIELD ..... gpm. Well water was ..... ft. after ..... hours pumping ..... gpm  
 Bore Hole Diameter **30** ..... in. to **520** ..... ft., and ..... in. to ..... ft.  
 WELL WATER TO BE USED AS:  Public water supply  Geothermal  Injection well  
 Domestic  Feedlot  Oil field water supply  Dewatering  Other (Specify below)  
 Irrigation  Industrial  Domestic-lawn & garden  Monitoring well .....  
 Was a chemical/bacteriological sample submitted to Department?  Yes  No  
 If yes, mo/day/yr sample was submitted.....  
 Water well disinfected?  Yes  No

**5 TYPE OF CASING USED:**  Steel  PVC  Other .....  
 CASING JOINTS:  Glued  Clamped  Welded  Threaded  
 Casing diameter **16** ..... in. to **BELOW** ..... ft., Diameter ..... in. to ..... ft., Diameter ..... in. to ..... ft.  
 Casing height above land surface **12** ..... in., Weight **42.05** ..... lbs./ft., Wall thickness or gauge No. **250**  
 TYPE OF SCREEN OR PERFORATION MATERIAL:  
 Steel  Stainless Steel  PVC  Other (Specify) .....  
 Brass  Galvanized Steel  None used (open hole)  
 SCREEN OR PERFORATION OPENINGS ARE:  
 Continuous slot  Mill slot  Gauze wrapped  Torch cut  Drilled holes  None (open hole)  
 Louvered shutter  Key punched  Wire wrapped  Saw cut  Other (specify) .....  
 SCREEN-PERFORATED INTERVALS: From **265** ..... ft. to **285** ..... ft., From **325** ..... ft. to **520** ..... ft.  
 From ..... ft. to ..... ft., From ..... ft. to ..... ft.  
 GRAVEL PACK INTERVALS: From **20** ..... ft. to **190** ..... ft., From **250** ..... ft. to **520** ..... ft.  
 From ..... ft. to ..... ft., From ..... ft. to ..... ft.

**6 GROUT MATERIAL:**  Neat cement  Cement grout  Bentonite  Other .....  
 Grout Intervals: From **0** ..... ft. to **20** ..... ft., From **190** ..... ft. to **250** ..... ft., From ..... ft. to ..... ft.  
 What is the nearest source of possible contamination:  
 Septic tank  Lateral lines  Pit privy  Livestock pens  Insecticide storage  Other (specify below)  
 Sewer lines  Cesspool  Sewage lagoon  Fuel storage  Abandoned water well  
 Watertight sewer lines  Seepage pit  Feedyard  Fertilizer storage  Oil well/gas well **N/A**  
 Direction from well ..... Distance from well .....

FROM	TO	LITHOLOGIC LOG	FROM	TO	LITHO. LOG (cont.) or PLUGGING INTERVALS
0'	265'	16" PLAIN CASING			
265'	285'	16" JOHNSON AGRI SCREEN			
285'	325'	16" PLAIN CASING			
325'	385'	16" PERFORATED CASING			
385'	405'	16" JOHNSON AGRI SCREEN			
405'	440'	16" PERFORATED CASING			
440'	500'	16" JOHNSON AGRI SCREEN			
500'	520'	16" PERFORATED CASING			

**7 CONTRACTOR'S OR LANDOWNER'S CERTIFICATION:** This water well was  constructed,  reconstructed, or  plugged under my jurisdiction and was completed on (mo/day/year) **6-4-09** ..... and this record is true to the best of my knowledge and belief.  
 Kansas Water Well Contractor's License No. **208** ..... This Water Well Record was completed on (mo/day/year) **6-4-09** .....  
 under the business name of **MINTER-WILSON DRILLING CO. INC.** ..... by (signature) *Nora Keller* .....

**INSTRUCTIONS:** Use typewriter or ball point pen. *PLEASE PRESS FIRMLY* and *PRINT* clearly. Please fill in blanks and check the correct answers. Send three copies (white, blue, pink) to Kansas Department of Health and Environment, Bureau of Water, Geology Section, 1000 SW Jackson St., Suite 420, Topeka, Kansas 66612-1367. Telephone 785-296-5522. Send one copy to WATER WELL OWNER and retain one for your records. Include fee of \$5.00 for each constructed well. Visit us at <http://www.kdheks.gov/waterwell/index.html>.

*The  
Professionals*

# MINTER-WILSON DRILLING CO.

INCORPORATED

Irrigation  
and Domestic  
Water Systems  
Complete Installation  
and Repairing

Phone 620-276-8269 • P.O. Box A • GARDEN CITY, KANSAS 67846

NAME FLETCHER RANCH - CIRCLE # A 1  
COUNTY KEARNY  
DATE 4-28-09

LOCATION: SW 1/4 31-25-35 - FROM LAKIN LANE & PARALLEL ROAD -  
2-3/4 MILES WEST & 1/4 MILE NORTH  
- 600 FT. SOUTHEAST OF PIVOT

STATIC WATER LEVEL - 220 FT.

## TEST # 5

0' TO 6' - TOP SOIL  
6' TO 13' - SANDY CLAY  
13' TO 98' - SAND & GRAVEL  
98' TO 100' - SANDY CLAY  
100' TO 120' - BLUE & BROWN CLAY & GRAVEL STREAKS  
120' TO 182' - BLUE & WHITE CLAY & A FEW GRAVEL STREAKS  
182' TO 186' - SAND & GRAVEL, MEDIUM TO COARSE  
186' TO 191' - BLUE & BROWN CLAY  
191' TO 202' - SAND & GRAVEL, MED TO COARSE  
202' TO 214' - BROWN & BLUE SANDY CLAY  
214' TO 229' - SAND & GRAVEL, MEDIUM TO COARSE  
229' TO 240' - BROWN & BLUE SANDY CLAY  
240' TO 262' - BROWN & BLUE CLAY & GRAVEL STREAKS  
262' TO 272' - SAND, MEDIUM  
272' TO 280' - BROWN SANDY CLAY  
280' TO 320' - BROWN SANDY CLAY & CALICHE  
320' TO 340' - BROWN & BLUE SANDY CLAY  
340' TO 381' - BROWN SANDY CLAY  
381' TO 400' - SAND, MEDIUM TO COARSE & A LITTLE CLAY  
400' TO 420' - BROWN CLAY  
420' TO 437' - BROWN CLAY & STREAKS OF BROWN ROCK  
437' TO 455' - FINE TO MEDIUM CEMENTED SAND & CLAY STREAKS  
- USED LOTS OF WATER  
455' TO 460' - YELLOW & GRAY CLAY & SAND STREAKS  
460' TO 480' - FINE TO MEDIUM SAND & 30% YELLOW, WHITE & GRAY CLAY  
480' TO 500' - YELLOW CLAY & FINE TO MEDIUM SAND STREAKS  
500' TO 520' - FINE SAND & YELLOW & BLUE CLAY STREAKS  
520' TO 540' - YELLOW CLAY & BLUE SHALE  
540' TO 560' - BLUE & BROWN SHALE - VERY HARD