

WATER WELL RECORD


Form WWC-5

Division of Water Resources App. No.

1 LOCATION OF WATER WELL: County: KEARNY Fraction 1/4 1/4 1/4 SW 1/4 NC Section Number 28 Township No. T 25 S Range Number R 35 [ ] E [x] W

Street/Rural Address of Well Location; if unknown, distance & direction from nearest town or intersection: If at owner's address, check here [ ]. S. SIDE OF LAKIN, 1 M S, 5-1/4 M E TO TATE LANE, 5 M S, 1,343 FT. NORTH & 3,913 FT. WEST

2 WATER WELL OWNER: FLETCHER RANCH, INC. RR#, Street Address, Box #: PO BOX C City, State, ZIP Code : LAKIN, KANSAS 67860 Global Positioning System (GPS) information: Latitude: 37.84690 Longitude: -101.17186

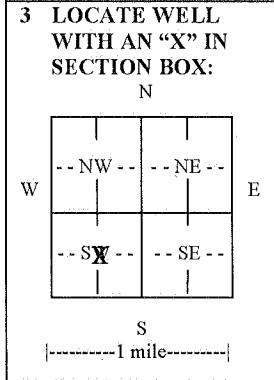

3 LOCATE WELL WITH AN 'X' IN SECTION BOX: 4 DEPTH OF COMPLETED WELL 480 ft. Depth(s) Groundwater Encountered (1) 240 ft. (2) ft. (3) ft. WELL'S STATIC WATER LEVEL 240 ft. below land surface measured on mo/day/yr. 5-23-12

5 TYPE OF CASING USED: [x] Steel [ ] PVC [ ] Other CASING JOINTS: [ ] Glued [ ] Clamped [x] Welded [ ] Threaded Casing diameter 16 in. to 280 ft., Diameter in. to ft., Diameter in. to ft. Casing height above land surface 12 in., Weight 42.05 lbs./ft., Wall thickness or gauge No. 250

6 GROUT MATERIAL: [ ] Neat cement [x] Cement grout [ ] Bentonite [ ] Other Grout Intervals: From 0 ft. to 20 ft., From 200 ft. to 260 ft., From ft. to ft. What is the nearest source of possible contamination: [ ] Septic tank [ ] Lateral lines [ ] Pit privy [ ] Livestock pens [ ] Insecticide storage [ ] Other (specify below)

Table with columns: FROM, TO, LITHOLOGIC LOG, FROM, TO, LITHO. LOG (cont.) or PLUGGING INTERVALS. Rows include: 0-280 16" PLAIN CASING, 280-320 16" JOHNSON AGRI SCREEN, 320-350 16" MILL SLOT PERF., 350-370 16" PLAIN CASING, 370-430 16" JOHNSON AGRI SCREEN, 430-450 16" PLAIN CASING, 450-470 16" JOHNSON AGRI SCREEN, 470-480 16" MILL SLOT PERF.

7 CONTRACTOR'S OR LANDOWNER'S CERTIFICATION: This water well was [x] constructed, [ ] reconstructed, or [ ] plugged under my jurisdiction and was completed on (mo/day/year) 5-23-12 and this record is true to the best of my knowledge and belief. Kansas Water Well Contractor's License No. 208 This Water Well Record was completed on (mo/day/year) 5-29-12 under the business name of MINTER-WILSON DRILLING CO., INC. by (signature) [Signature]

INSTRUCTIONS: Use typewriter or ball point pen. PLEASE PRESS FIRMLY and PRINT clearly. Please fill in blanks and check the correct answers. Send three copies (white, blue, pink) to Kansas Department of Health and Environment, Bureau of Water, Geology Section, 1000 SW Jackson St., Suite 420, Topeka, Kansas 66612-1367. Telephone 785-296-5524. Send one copy to WATER WELL OWNER and retain one for your records. I include fee of \$5.00 for each constructed well. Visit us at http://www.kdheks.gov/waterwell/index.html.

*The  
Professionals*

# MINTER-WILSON DRILLING CO.

INCORPORATED

Irrigation  
and Domestic  
Water Systems  
Complete Installation  
and Repairing

Phone 620-276-8269 • P.O. Box A • GARDEN CITY, KANSAS 67846

NAME FLETCHER RANCH - CIRCLE # 13  
COUNTY KEARNY  
DATE 11-9-11

LOCATION: SW 1/4 28-25-35 - SOUTH ON TATE LANE TO PARALLEL ROAD -  
1 MILE NORTH, 1/2 MILE WEST,  
1/4 MILE NORTH & 1/4 MILE WEST  
- NORTH OF PIVOT

STATIC WATER LEVEL - 250 FT.

## TEST # 1

0' TO 1' - TOP SOIL  
1' TO 10' - BROWN SANDY CLAY  
10' TO 18' - BROWN CLAY  
18' TO 35' - FINE TO MEDIUM SAND & GRAVEL  
35' TO 93' - FINE TO MEDIUM SAND & GRAVEL - SOME COARSE  
93' TO 119' - BROWN CLAY  
119' TO 129' - BROWN CLAY WITH GRAVEL STREAKS  
129' TO 176' - BROWN & BLUE CLAY WITH SMALL GRAVEL STREAKS  
176' TO 209' - BLUE CLAY  
209' TO 219' - FINE TO MEDIUM SAND & GRAVEL  
219' TO 226' - BROWN CLAY  
226' TO 232' - FINE TO MEDIUM SAND & GRAVEL - 10% CLAY  
232' TO 248' - BROWN CLAY  
248' TO 287' - FINE TO MEDIUM SAND & GRAVEL  
287' TO 306' - BROWN CLAY WITH WHITE ROCK MIXED  
306' TO 369' - BROWN CLAY  
369' TO 374' - FINE TO MEDIUM SAND  
374' TO 394' - BROWN SANDY CLAY  
394' TO 407' - FINE TO MEDIUM SAND & GRAVEL  
407' TO 414' - BROWN CLAY  
414' TO 418' - FINE TO MEDIUM SAND  
418' TO 435' - BROWN SANDY CLAY  
435' TO 459' - BROWN CLAY  
459' TO 466' - BROWN ROCK - LOOSE  
466' TO 481' - BROWN YELLOW CLAY  
481' TO 485' - SHALE