

WATER WELL PLUGGING RECORD Form WWC-5P KSA 82a-1212 ID NO.

[]


1 LOCATION OF WATER WELL: Fraction NE 1/4 NE 1/4 NE 1/4 SW 1/4 Section Number 22 Township Number T 25 S Range Number 35 E W
 County: Kearyn

Street/Rural Address of Well Location; if unknown, distance & direction from nearest town or intersection: If at owner's address, check here Eight miles south and one half mile west of Deerfield KS.

Global Positioning Systems (GPS) information:
 Latitude: 37.864840 (in decimal degrees)
 Longitude: -101.150404 (in decimal degrees)
 Elevation: 2998
 Horizontal Datum: WGS84, NAD83, NAD27
 Collection Method:

2 WATER WELL OWNER: Graham Farms Inc.
 RR#, St. Address, Box #: 2156 road 220
 City, State ZIP Code: Deerfield Ks. 67838

GPS unit (Make/Model: cell phone)
 Digital Map/Photo, Topographic Map, Land Survey
 Est. Accuracy: < 3 m, 3-5 m, 5-15 m, > 15 m

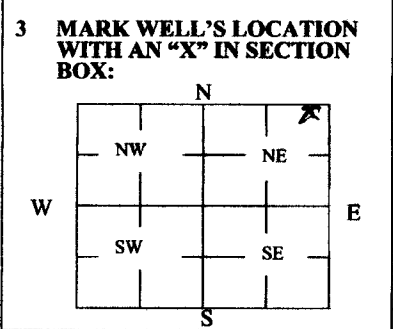

4 DEPTH OF WELL 422 ft.
WELL'S STATIC WATER LEVEL 285 ft
WELL WAS USED AS:
 Domestic Public Water Supply Dewatering
 Irrigation Oil Field Water Supply Monitoring
 Feedlot Domestic (Lawn & Garden) Injection Well
 Industrial Air Conditioning Other _____
 Was a chemical/bacteriological sample submitted to Department? Yes No

5 TYPE OF BLANK CASING USED:
 Steel RMP (SR) Wrought Fiberglass Other (Specify below)
 PVC ABS Asbestos-Cement Concrete Tile
 Blank casing diameter 16 in. Was casing pulled? Yes No If yes, how much 5ft. cut off or 4ft. below surface
 Casing height above or below land surface 12 in.

6 GROUT PLUG MATERIAL: Neat cement Cement grout Bentonite Other _____
 Grout Plug Intervals: From 7.5 ft. to 3.5 ft., From _____ ft. to _____ ft., From _____ ft. to _____ ft.
 What is the nearest source of possible contamination:
 Septic tank Seepage pit Fuel storage Other (specify below)
 Sewer lines Pit privy Fertilizer storage 1000gal. used for irrigation
 Watertight sewer lines Sewage lagoon Insecticide storage
 Lateral lines Feedyard Abandoned water well Direction from well? NW
 Cess pool Livestock pens Oil well/Gas well How many feet? 975

FROM	TO	PLUGGING MATERIALS	FROM	TO	PLUGGING MATERIALS
422 ft.	275 ft.	washed gravel			
275 ft.	7.5 ft.	clay silt soil			
7.5 ft.	4.25 ft.	cement grout			
4.25 ft.	3.5 ft.	cement grout top 14in. thick 42in. dia			

7 CONTRACTOR'S OR LANDOWNER'S CERTIFICATION: This water well was plugged under my jurisdiction and was completed on (mo/day/year) 12-11-2015 and this record is true to the best of my knowledge and belief. Kansas Water Well Contractor's License No. 970. This Water Well Record was completed on (mo/day/year) 12-26-2015 under the business name of _____ by (signature) *[Signature]*

Send one white copy to Kansas Department of Health & Environment, Geology Section, 1000 SW Jackson Street, Ste. 420, Topeka, KS 66612-1367. Send one copy to WATER WELL OWNER and retain one for your records.
 Visit us at <http://www.kdheks.gov/waterwell/index.html> Telephone 785-296-5524.

X