

CORRECTION(S) TO WATER WELL RECORD (WWC-5)
(to rectify lacking or incorrect information)

Location listed as:

Section-Township-Range: 10-25-37W

Fraction ($\frac{1}{4}$ $\frac{1}{4}$ $\frac{1}{4}$): NE SW NE

County: Kearny

Location changed to:

10-25S-36W

NE SW NE

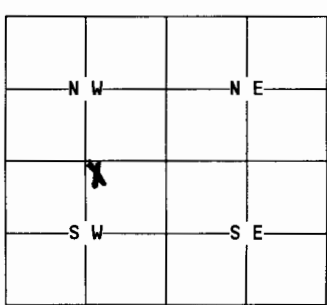
Other changes: Initial statements: _____

Changed to: _____

Comments: Plat map is believed to represent the NE quarter of the section.

verification method: Written & legal descriptions, area map, position on plat map, and mapping tool & aerial photos on KGS website. initials: DRL date: 2/10/2009

submitted by: Kansas Geological Survey, Data Resources Library, 1930 Constant Ave., Lawrence, KS 66047-3726
to: Kansas Dept of Health & Environment, Bureau of Water, 1000 SW Jackson, Suite 420, Topeka, KS 66612-1367.

1 LOCATION OF WATER WELL:		Fraction	Section Number	Township Number	Range Number																								
County: <u>KEARNY</u>		<u>NE 1/4 SW 1/4 NE 1/4</u>	<u>10</u>	<u>25</u>	<u>37W</u>																								
Distance and direction from nearest town or city street address of well if located within city? <u>2 MILES SOUTH OF LAKIN IN BEYMER PARK</u>																													
2 WATER WELL OWNER: <u>KEARNY COUNTY</u>																													
RR#, St. Address, Box #: <u>P.O. Box 86</u>			Board of Agriculture, Division of Water Resources																										
City, State, ZIP Code: <u>LAKIN, KS 67860</u>			Application Number:																										
3 MARK WELL'S LOCATION WITH AN "X" IN SECTION BOX: N		4 DEPTH OF WELL..... <u>244</u>ft.																											
		WELL'S STATIC WATER LEVEL..... <u>19</u>ft.																											
S		WELL WAS USED AS:																											
		<table border="0"><tr><td><input checked="" type="radio"/> 1 Domestic</td><td><input type="radio"/> 5 Public Water Supply</td><td><input type="radio"/> 9 Dewatering</td></tr><tr><td><input type="radio"/> 2 Irrigation</td><td><input type="radio"/> 6 Oil Field Water Supply</td><td><input type="radio"/> 10 Monitoring Well</td></tr><tr><td><input type="radio"/> 3 Feedlot</td><td><input type="radio"/> 7 Lawn and Garden Only</td><td><input type="radio"/> 11 Injection Well</td></tr><tr><td><input type="radio"/> 4 Industrial</td><td><input type="radio"/> 8 Air Conditioning</td><td><input type="radio"/> 12 Other.....</td></tr>
Was a chemical/bacteriological sample submitted to Department? Yes....No <input checked="" type="checkbox"/> ..																													
If yes, mo/day/yr sample was submitted.....																													
Water Well Disinfected: Yes. <input checked="" type="checkbox"/> ... No.....																													
5 TYPE OF BLANK CASING USED:																													
<table border="0"><tr><td><input checked="" type="radio"/> 1 Steel</td><td><input type="radio"/> 3 RMP (SR)</td><td><input type="radio"/> 5 Wrought</td><td><input type="radio"/> 7 Fiberglass</td><td><input type="radio"/> 9 Other (specify below)</td></tr><tr><td><input type="radio"/> 2 PVC</td><td><input type="radio"/> 4 ABS</td><td><input type="radio"/> 6 Asbestos-Cement</td><td><input type="radio"/> 8 Concrete Tile</td><td></td></tr>
Blank casing diameter..... <u>8"</u>in. Was casing pulled? Yes..... No <input checked="" type="checkbox"/> ... If yes, how much.....																													
Casing height above or below land surface..... <u>36</u>in.																													
6 GROUT PLUG MATERIAL: <input type="radio"/> 1 Neat cement <input type="radio"/> 2 Cement grout <input checked="" type="radio"/> 3 Bentonite <input type="radio"/> 4 Other.....																													
Grout Plug Intervals: From..... <u>6</u>ft. to..... <u>3</u>ft., From.....ft. to.....ft., From..... to.....ft.																													
What is the nearest source of possible contamination:																													
<table border="0"><tr><td><input type="radio"/> 1 Septic tank</td><td><input type="radio"/> 6 Seepage pit</td><td><input type="radio"/> 11 Fuel storage</td><td><input type="radio"/> 16 Other (specify below)</td></tr><tr><td><input type="radio"/> 2 Sewer lines</td><td><input type="radio"/> 7 Pit privy</td><td><input type="radio"/> 12 Fertilizer storage</td><td></td></tr><tr><td><input checked="" type="radio"/> 3 Watertight sewer lines</td><td><input type="radio"/> 8 Sewage lagoon</td><td><input type="radio"/> 13 Insecticide storage</td><td></td></tr><tr><td><input type="radio"/> 4 Lateral lines</td><td><input type="radio"/> 9 Feedyard</td><td><input type="radio"/> 14 Abandoned water well</td><td></td></tr><tr><td><input type="radio"/> 5 Cess Pool</td><td><input type="radio"/> 10 Livestock pens</td><td><input type="radio"/> 15 Oil well/Gas well</td><td></td></tr>
Direction from well? <u>WEST</u> How many feet? <u>200</u> '.....																													
<table border="1"><thead><tr><th>FROM</th><th>TO</th><th>PLUGGING MATERIALS</th></tr></thead><tbody><tr><td><u>244'</u></td><td><u>19'</u></td><td><u>CHLORINATED SAND</u></td></tr><tr><td><u>19'</u></td><td><u>6'</u></td><td><u>SUBSOIL</u></td></tr><tr><td><u>6'</u></td><td><u>3'</u></td><td><u>BENTONITE PLUG</u></td></tr><tr><td><u>3'</u></td><td><u>0'</u></td><td><u>TOPSOIL</u></td></tr><tr><td> </td><td> </td><td> </td></tr><tr><td> </td><td> </td><td> </td></tr><tr><td> </td><td> </td><td> </td></tr>
7 CONTRACTOR'S OR LANDOWNER'S CERTIFICATION: This water well was plugged under my jurisdiction and was completed on (mo/day/year)..... <u>8-30-97</u> and this record is true to the best of my knowledge and belief. Kansas Water Well Contractor's License No. <u>003</u> This Water Well Record was completed on (mo/day/year) <u>3-11-97</u> under the business name of..... by (signature) <u>Randy Layzell</u>																													
INSTRUCTIONS: Use typewriter or ball point pen. Please press firmly and print clearly. Please fill in blanks, underline or circle the correct answers. Send top three copies to Kansas Department of Health and Environment, Bureau of Water, Topeka, Kansas 66620-0001. Telephone: 913/296-3565. Send one to Water Well Owner and retain one for your records.																													