WATER WELL RECORD Form WWC-5 KSA 82a-1212

1 LOCATION OF WATER WELL: County: Kearney | Fraction: NW ¼ NW ¼ NE ¼ | Section Number: 15 | Township Number: T 25 S | Range Number: R 36 E(W)

Distance and direction from nearest town or city street address of well if located within city?
3 miles south & ½ mile west of Kakin, Ks. Lots 1&6 of Country Club Heights Subdivison

2 WATER WELL OWNER: Ken & Judy Anderson
RR#, St. Address, Box # :
City, State, ZIP Code : Kakin, Ks. 67860

Board of Agriculture, Division of Water Resources
Application Number:

3 LOCATE WELL'S LOCATION WITH AN "X" IN SECTION BOX:

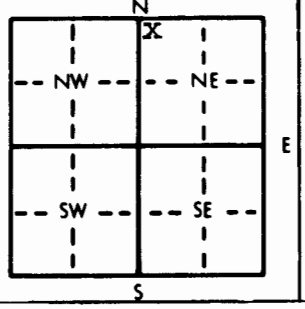

4 DEPTH OF COMPLETED WELL 250 ft. ELEVATION:
Depth(s) Groundwater Encountered 1. ft. 2. ft. 3. ft.
WELL'S STATIC WATER LEVEL 54 ft. below land surface measured on mo/day/yr 8-21-86
Pump test data: Well water was ft. after hours pumping gpm
Est. Yield 50 gpm: Well water was ft. after hours pumping gpm
Bore Hole Diameter 12 in. to 250 ft., and in. to ft.
WELL WATER TO BE USED AS: 5 Public water supply 8 Air conditioning 11 Injection well
X Domestic 3 Feedlot 6 Oil field water supply 9 Dewatering 12 Other (Specify below)
2 Irrigation 4 Industrial 7 Lawn and garden only 10 Observation well
Was a chemical/bacteriological sample submitted to Department? Yes No X; If yes, mo/day/yr sample was submitted
Water Well Disinfected? Yes X No

5 TYPE OF BLANK CASING USED: 5 Wrought iron 8 Concrete tile CASING JOINTS: Glued X Clamped
1 Steel 3 RMP (SR) 6 Asbestos-Cement 9 Other (specify below) Welded
X PVC 4 ABS 7 Fiberglass Threaded
Blank casing diameter 5 in. to 200 ft., Dia 240 in. to 250 ft., Dia in. to ft.
Casing height above land surface 12 in., weight lbs./ft. Wall thickness or gauge No. 200 psi

TYPE OF SCREEN OR PERFORATION MATERIAL: X PVC 10 Asbestos-cement
1 Steel 3 Stainless steel 5 Fiberglass 8 RMP (SR) 11 Other (specify)
2 Brass 4 Galvanized steel 6 Concrete tile 9 ABS 12 None used (open hole)

SCREEN OR PERFORATION OPENINGS ARE: 5 Gauzed wrapped X 8 Saw cut 11 None (open hole)
1 Continuous slot 3 Mill slot 6 Wire wrapped 9 Drilled holes
2 Louvered shutter 4 Key punched 7 Torch cut 10 Other (specify)

SCREEN-PERFORATED INTERVALS: From 200 ft. to 210 ft., From ft. to ft.
From 240 ft. to 250 ft., From ft. to ft.
GRAVEL PACK INTERVALS: From 15 ft. to 190 ft., From ft. to ft.
From 200 ft. to 250 ft., From ft. to ft.

6 GROUT MATERIAL: 1 Neat cement X Cement grout 3 X Bentonite 4 Other
Grout Intervals: From 5 ft. to 15 ft., From 190 ft. to 195 ft., From ft. to ft.

What is the nearest source of possible contamination:
X Septic tank 4 Lateral lines 7 Pit privy 10 Livestock pens 14 Abandoned water well
2 Sewer lines 5 Cess pool 8 Sewage lagoon 11 Fuel storage 15 Oil well/Gas well
3 Watertight sewer lines 6 Seepage pit 9 Feedyard 12 Fertilizer storage 16 Other (specify below)
13 Insecticide storage
Direction from well? How many feet? 100

FROM	TO	LITHOLOGIC LOG	FROM	TO	LITHOLOGIC LOG
0	2	top soil			
2	25	coarse sand & gravel			
25	40	brown clay			
40	60	coarse sand & gravel			
60	80	brown clay			
80	140	fine & coarse sand & gravel			
140	180	fine & coarse sand, clay streaks			
180	210	fine & coarse sand & gravel			
210	220	brown clay & gypsum			
220	240	fine sand & clay streaks			
240	250	fine & medium sand			

7 CONTRACTOR'S OR LANDOWNER'S CERTIFICATION: This water well was X (1) constructed, (2) reconstructed, or (3) plugged under my jurisdiction and was completed on (mo/day/year) 8-21-86 and this record is true to the best of my knowledge and belief. Kansas Water Well Contractor's License No. 449 This Water Well Record was completed on (mo/day/yr) 8-25-86
under the business name of Midwest Well & Pump by (signature) Arthur Kuhlmann

INSTRUCTIONS: Use typewriter or ball point pen. *PLEASE PRESS FIRMLY* and *PRINT* clearly. Please fill in blanks, underline or circle the correct answers. Send top three copies to Kansas Department of Health and Environment, Office of Oil Field and Environmental Geology, Regulation and Permitting Section, Topeka, Kansas 66620-7500, Telephone: 913-862-9360. Send one to WATER WELL OWNER and retain one for your records.

OFFICE USE ONLY T R E/W SEC. ¼ ¼ ¼