

WATER WELL RECORD Form WWC-5 KSA 82a-1212

1 LOCATION OF WATER WELL:	Fraction	Section Number	Township Number	Range Number
COUNTY: 047 KEARNY	NW 1/4 NW 1/4 SW 1/4	12	T 25 S	R 36 W

Distance and direction from nearest town or city street address of well if located within city?

FROM LAKIN; APPX 2 3/4 MILES SOUTH & 1 MILE EAST

2 WATER WELL OWNER: CEB, INC.

RR#, St. Address, Box # : PO BOX 363

Board of Agriculture, Division of Water Resources

City, State, ZIP code : LAKIN, KS 67860-0363

Application Number: 21,056

3 LOCATE WELL'S LOCATION WITH

AN "X" IN SECTION BOX:

/ \					
	X				
1		NW		NE	
M					
i	W				E
l					
e					
		SW		SE	
\ /					

4 DEPTH OF COMPLETED WELL 340 ELEVATION: 0

Depth(s) Groundwater Encountered 1. 0 ft. 2. 0 ft. 3. 0 ft.

WELL'S STATIC WATER LEVEL 58 ft. below land surface measured on mo/day/yr 03/22/07

Pump test data: Well water was 130 ft. after 4 hours pumping 685 gpm

Estimated Yield 0 gpm: Well water was 0 ft. after 0 hours pumping 0 gpm

Bore Hole Diameter 24 in. to 340 ft., and in. to 0 ft.

WELL WATER TO BE USED AS: 02 IRRIGATION

Was a chemical/bacteriological sample submitted to department? No ;

If yes, mo/day/yr sample was submitted Water well disinfected? Yes

5 TYPE OF BLANK CASING USED: 01 STEEL

CASING JOINTS: WELDED

Blank casing diameter 16 in. to 340 ft., Dia in. to 0 ft., Dia in. to 0 ft.

Casing height above land surface 12 in., weight 42 lbs/ft. Wall thickness or gauge No. .250

TYPE OF SCREEN OR PERFORATION MATERIAL: 01 STEEL

SCREEN OR PERFORATION OPENINGS ARE: 01 CONT. SLOT

SCREEN PERFORATED INTERVALS: From 75 ft. to 175 ft., From 253 ft. to 293 ft.

From 200 ft. to 220 ft., From 315 ft. to 335 ft.

GRAVEL PACK INTERVALS: From 20 ft. to 340 ft., From 0 ft. to 0 ft.

From 0 ft. to 0 ft., From 0 ft. to 0 ft.

6 GROUT MATERIAL 03 BENTONITE

Grout Intervals: From 0 ft. to 20 ft., From 0 ft. to 0 ft., From 0 ft. to 0 ft.

What is the nearest source of possible contamination: NONE OBSERVED

Direction from well?

How many feet? 0

FROM	TO	LITHOLOGIC LOG	FROM	TO	PLUGGING INTERVALS
0	1	02 SILT			
1	20	05 SAND 11 GRAVEL			
20	26	01 CLAY			
26	63	05 SAND 11 GRAVEL 01 CLAY			
63	80	04 SANDY CLAY 05 SAND			
80	104	05 SAND 01 CLAY			
104	117	01 CLAY			
117	154	05 SAND			
154	160	04 SANDY CLAY			
160	175	07 FINE SAND 08 MEDIUM SAND 01 CLAY			

7 CONTRACTOR'S OR LANDOWNER'S CERTIFICATION: This water well was Constructed under my jurisdiction and was completed on (mo/day/year) 03/20/07 and this record is true to the best of my knowledge and belief. Kansas

Water Well Contractor's License No. 145 This Water Well Record was completed on (mo/day/yr) 05/01/07

under the business name of HENKLE DRILLING & SUPPLY by (signature)

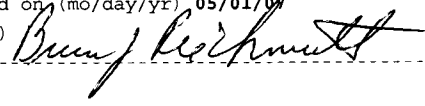
(Continued)

WATER WELL RECORD Form WWC-5 KSA 82a-1212

1 LOCATION OF WATER WELL:	Fraction	Section Number	Township Number	Range Number
COUNTY: 047 KEARNY	NW 1/4 NW 1/4 SW 1/4	12	T 25 S	R 36 W

2 WATER WELL OWNER:	CEB, INC.	Board of Agriculture, Division of Water Resources
RR#, St. Address, Box # :	PO BOX 363	Application Number: 21,056
City, State, ZIP code :	LAKIN, KS 67860-0363	

FROM	TO	LITHOLOGIC LOG
175	202	01 CLAY
202	220	01 CLAY 05 SAND
220	259	01 CLAY 05 SAND
259	268	07 FINE SAND
268	278	01 CLAY
278	293	05 SAND
293	302	01 CLAY
302	317	01 CLAY 20 LIMESTONE
317	335	07 FINE SAND
335	346	01 CLAY 05 SAND
346	380	31 CALICHE 20 LIMESTONE 23 SANDSTONE
380	400	31 CALICHE 19 SHALE

7 CONTRACTOR'S OR LANDOWNER'S CERTIFICATION: This water well was Constructed under my jurisdiction and was completed on (mo/day/year) 03/20/07 and this record is true to the best of my knowledge and belief. Kansas	This Water Well Record was completed on (mo/day/yr) 05/01/07
Water Well Contractor's License No. 145	by (signature) 
under the business name of HENKLE DRILLING & SUPPLY	