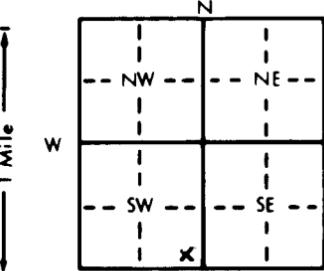


1 LOCATION OF WATER WELL:		Fraction		Section Number		Township Number		Range Number	
County: Kearny		SE 1/4 SE 1/4 SW 1/4		23		T 25 S		R 36 EW	
Distance and direction from nearest town or city street address of well if located within city?									
From Lakin, 5 miles south, then 1 mile east									
2 WATER WELL OWNER: Kelly Koehn									
RR#, St. Address, Box #: RFD									
City, State, ZIP Code: Lakin, KS. 67860									
Board of Agriculture, Division of Water Resources									
Application Number:									
3 LOCATE WELL'S LOCATION WITH AN "X" IN SECTION BOX:		4 DEPTH OF COMPLETED WELL: 370 ft. ELEVATION:							
		Depth(s) Groundwater Encountered 1. ft. 2. ft. 3. ft.							
		WELL'S STATIC WATER LEVEL 131 ft. below land surface measured on mo/day/yr 1-28-98							
		Pump test data: Well water was ft. after hours pumping gpm							
		Est. Yield gpm; Well water was ft. after hours pumping gpm							
		Bore Hole Diameter 7 7/8 in. to 370 ft., and in. to ft.							
		WELL WATER TO BE USED AS: 5 Public water supply 8 Air conditioning 11 Injection well							
		1 Domestic 3 Feedlot 6 Oil field water supply 9 Dewatering 12 Other (Specify below)							
		2 Irrigation 4 Industrial 7 Lawn and garden only 10 Monitoring well							
		Was a chemical/bacteriological sample submitted to Department? Yes No X; If yes, mo/day/yr sample was submitted							
		Water Well Disinfected? Yes X No							
5 TYPE OF BLANK CASING USED:									
1 Steel 3 RMP (SR) 5 Wrought iron 8 Concrete tile CASING JOINTS: Glued X Clamped									
2 PVC 4 ABS 6 Asbestos-Cement 9 Other (specify below) Welded									
7 Fiberglass Threaded									
Blank casing diameter 5 in. to 330 ft., Dia in. to ft., Dia in. to ft.									
Casing height above land surface 12 in., weight lbs./ft. Wall thickness or gauge No. 30R 21									
TYPE OF SCREEN OR PERFORATION MATERIAL:									
1 Steel 3 Stainless steel 5 Fiberglass 8 RMP (SR) 10 Asbestos-cement									
2 Brass 4 Galvanized steel 6 Concrete tile 9 ABS 11 Other (specify)									
12 None used (open hole)									
SCREEN OR PERFORATION OPENINGS ARE:									
1 Continuous slot 5 Gauzed wrapped 8 Saw cut 11 None (open hole)									
2 Louvered shutter 6 Wire wrapped 9 Drilled holes									
4 Key punched 7 Torch cut 10 Other (specify)									
SCREEN-PERFORATED INTERVALS: From 530 ft. to 570 ft., From ft. to ft.									
From ft. to ft., From ft. to ft.									
GRAVEL PACK INTERVALS: From 24 ft. to 300 ft., From 305 ft. to 370 ft.									
From ft. to ft., From ft. to ft.									
6 GROUT MATERIAL:									
1 Neat cement 2 Cement grout 3 Bentonite 4 Other									
Grout Intervals: From 4 ft. to 24 ft., From 300 ft. to 305 ft., From ft. to ft.									
What is the nearest source of possible contamination:									
1 Septic tank 4 Lateral lines 7 Pit privy 10 Livestock pens 14 Abandoned water well									
2 Sewer lines 5 Cess pool 8 Sewage lagoon 11 Fuel storage 15 Oil well/Gas well									
3 Watertight sewer lines 6 Seepage pit 9 Feedyard 12 Fertilizer storage 16 Other (specify below)									
13 Insecticide storage									
Direction from well? North How many feet? 50									
FROM TO LITHOLOGIC LOG FROM TO PLUGGING INTERVALS									
0 2 Sandy Topsoil 240 259 Course sand									
2 26 Course sand 259 272 Brown clay									
26 28 Brown clay 272 300 Course sand									
28 68 Course sand + brown clay layers 300 305 Brown clay									
68 81 Brown clay 305 370 Course sand									
81 89 Brown sandy clay									
89 101 Brown clay									
101 110 Brown sandy clay									
110 123 Brown sandy clay									
123 180 Blue clay									
180 204 Blue sandy clay									
204 220 Med. sand									
220 225 Blue clay									
225 229 Course sand									
229 240 Blue clay									
7 CONTRACTOR'S OR LANDOWNER'S CERTIFICATION: This water well was (1) constructed, (2) reconstructed, or (3) plugged under my jurisdiction and was completed on (mo/day/year) 1-30-98 and this record is true to the best of my knowledge and belief. Kansas Water Well Contractor's License No. 533 This Water Well Record was completed on (mo/day/yr) 3-18-98 under the business name of Santzen Water Well Repair by signature [Signature]									
INSTRUCTIONS: Use typewriter or ball point pen. PLEASE PRESS FIRMLY and PRINT clearly. Please fill in blanks, underline or circle the correct answers. Send top three copies to Kansas Department of Health and Environment, Bureau of Water, Topeka, Kansas 66620-0001. Telephone: 913-296-5545. Send one to WATER WELL OWNER and retain one for your records.									