

WATER WELL RECORD

Form WWC-5


Division of Water Resources App. No.

1 LOCATION OF WATER WELL: County: Kearny	Fraction ¼ NW ¼ NW ¼ NE ¼	Section Number 23	Township No. T 25 S	Range Number R 36 <input type="checkbox"/> E <input checked="" type="checkbox"/> W
--	------------------------------	----------------------	------------------------	---

Street/Rural Address of Well Location; if unknown, distance & direction from nearest town or intersection: If at owner's address, check here .
RD. T & RD. 100 2740' East 175' South

Global Positioning System (GPS) information:
Latitude: (in decimal degrees)
Longitude: (in decimal degrees)
Elevation:
Datum: WGS 84. NAD 83. NAD 27
Collection Method:
 GPS unit (Make/Model:)
 Digital Map/Photo. Topographic Map. Land Survey
Est. Accuracy: <3 m. 3-5 m. 5-15 m. >15 m

2 WATER WELL OWNER: Tyson Nichols
RR#, Street Address, Box #: 984 Rd. T
City, State, ZIP Code : Lakin, KS 67860

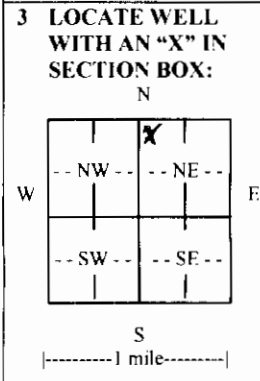

4 DEPTH OF COMPLETED WELL 333 ft.

Depth(s) Groundwater Encountered (1)..... ft. (2)..... ft. (3)..... ft.
WELL'S STATIC WATER LEVEL 185 ft. below land surface measured on mo/day/yr.....
Pump test data: Well water was 201 ft. after 4 hours pumping 60 gpm
EST. YIELD..... gpm. Well water was ft. after hours pumping..... gpm
Bore Hole Diameter 10 in. to 333 ft., and in. to ft.
WELL WATER TO BE USED AS: Public water supply Geothermal Injection well
 Domestic Feedlot Oil field water supply Dewatering Other (Specify below)
 Irrigation Industrial Domestic-lawn & garden Monitoring well
Was a chemical/bacteriological sample submitted to Department? Yes No
If yes, mo/day/yr sample was submitted.....
Water well disinfected? Yes No

5 TYPE OF CASING USED: Steel PVC Other
CASING JOINTS: Glued Clamped Welded Threaded
Casing diameter 5 in. to 273 ft., Diameter in. to ft., Diameter in. to ft.
Casing height above land surface 18 in., Weight 200 lbs./ft., Wall thickness or gauge No. SDR21.....
TYPE OF SCREEN OR PERFORATION MATERIAL:
 Steel Stainless Steel PVC Other (Specify)
 Brass Galvanized Steel None used (open hole)
SCREEN OR PERFORATION OPENINGS ARE:
 Continuous slot Mill slot Gauze wrapped Torch cut Drilled holes None (open hole)
 Louvered shutter Key punched Wire wrapped Saw cut Other (specify)
SCREEN-PERFORATED INTERVALS: From 273 ft. to 333 ft., From ft. to ft.
From ft. to ft., From ft. to ft.
GRAVEL PACK INTERVALS: From 50 ft. to 333 ft., From ft. to ft.
From ft. to ft., From ft. to ft.

6 GROUT MATERIAL: Neat cement Cement grout Bentonite Other
Grout Intervals: From 5 ft. to 50 ft., From ft. to ft., From ft. to ft.
What is the nearest source of possible contamination:
 Septic tank Lateral lines Pit privy Livestock pens Insecticide storage Other (specify below)
 Sewer lines Cesspool Sewage lagoon Fuel storage Abandoned water well
 Watertight sewer lines Seepage pit Feedyard Fertilizer storage Oil well/gas well
Direction from well West Distance from well 425'.....

FROM	TO	LITHOLOGIC LOG	FROM	TO	LITHO. LOG (cont.) or PLUGGING INTERVALS
0	2	Top Soil	148	185	Brown Clay With Med to Cor Sand Str
2	24	Coarse Sand Small to Medium Gravel	185	225	Coarse Sand With Few Brown Clay Str
24	25	Brown Clay	225	245	Brown Clay With Small Fine Sand Str
25	40	Coarse Sand Med. to Large Gravel	245	265	Fine to Medium Sand, Brown Clay Str
40	65	Brown Sandy Clay	265	285	Brown Clay With Very Fine Sand Str.
65	105	Brown Sandy Clay, Large Gravel Str.	285	305	Very Fine to Fine Sand Few Brown
105	115	Brown Clay			Clay Streaks
115	125	Light Blue Clay	305	325	Fine to Medium Sand
125	145	Light Blue Clay With Coarse Sand St	325	333	Rainbow Shale With Hard Sandstone
145	148	Medium to Coarse Sand			Streaks

7 CONTRACTOR'S OR LANDOWNER'S CERTIFICATION: This water well was constructed, reconstructed, or plugged under my jurisdiction and was completed on (mo/day/year) 4-12-17..... and this record is true to the best of my knowledge and belief. Kansas Water Well Contractor's License No. 532..... This Water Well Record was completed on (mo/day/year) 4-25-17..... under the business name of Midwest Well & Pump Inc..... by (signature).....

INSTRUCTIONS: Use typewriter or ball point pen. PLEASE PRESS FIRMLY and PRINT clearly. Please fill in blanks and check the correct answers. Send three copies (white, blue, pink) to Kansas Department of Health and Environment, Bureau of Water, Geology Section, 1000 SW Jackson St., Suite 420, Topeka, Kansas 66612-1367. Telephone 785-296-5522. Send one copy to WATER WELL OWNER and retain one for your records. Include fee of \$5.00 for each constructed well. Visit us at <http://www.kdheks.gov/waterwell/index.html>.