


1 LOCATION OF WATER WELL: Fraction SE 1/4 SW 1/4 SW 1/4 Section Number 7 Township Number T 25 S Range Number R 36 E/W
 County: KEARNY

Distance and direction from nearest town or city street address of well if located within city?

3 MILES SOUTH 3 MILES WEST OF LAKIN

2 WATER WELL OWNER: CLYDE BEYMER
 RR#, St. Address, Box # : P.O. BOX 363 Board of Agriculture, Division of Water Resources
 City, State, ZIP Code : LAKIN, KANSAS 67850 Application Number:

3 LOCATE WELL'S LOCATION WITH AN "X" IN SECTION BOX:

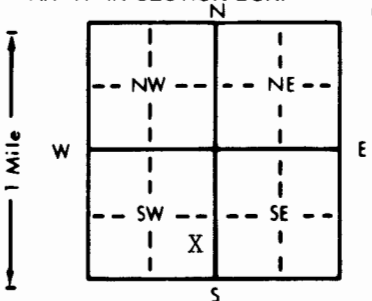

4 DEPTH OF COMPLETED WELL: 40 ft. ELEVATION:
 Depth(s) Groundwater Encountered 1. ft. 2. ft. 3. ft.
 WELL'S STATIC WATER LEVEL: DRY 0 ft. below land surface measured on mo/day/yr 7-26-94
 Pump test data: Well water was ft. after hours pumping gpm
 Est. Yield gpm: Well water was ft. after hours pumping gpm
 Bore Hole Diameter in. to ft., and in. to ft.
 WELL WATER TO BE USED AS: 1 5 Public water supply 8 Air conditioning 11 Injection well
 3 Feedlot 6 Oil field water supply 9 Dewatering 12 Other (Specify below)
 2 Irrigation 4 Industrial 7 Lawn and garden only 10 Monitoring well
 Was a chemical/bacteriological sample submitted to Department? Yes No; If yes, mo/day/yr sample was submitted
 Water Well Disinfected? Yes No X

5 TYPE OF BLANK CASING USED: 1 Steel 3 RMP (SR) 5 Wrought iron 8 Concrete tile CASING JOINTS: Glued Clamped
 2 PVC 4 ABS 6 Asbestos-Cement 9 Other (specify below) Welded
 7 Fiberglass Threaded

Blank casing diameter . . 18 in. to ft., Dia in. to ft., Dia in. to ft.
 Casing height above land surface . . 13 in., weight lbs./ft. Wall thickness or gauge No.

TYPE OF SCREEN OR PERFORATION MATERIAL:
 1 Steel 3 Stainless steel 5 Fiberglass 8 RMP (SR) 10 Asbestos-cement
 2 Brass 4 Galvanized steel 6 Concrete tile 9 ABS 11 Other (specify) NA
 12 None used (open hole)

SCREEN OR PERFORATION OPENINGS ARE:
 1 Continuous slot 3 Mill slot 5 Gauzed wrapped 8 Saw cut 11 None (open hole)
 2 Louvered shutter 4 Key punched 6 Wire wrapped 9 Drilled holes
 7 Torch cut 10 Other (specify) NA

SCREEN-PERFORATED INTERVALS: From NA ft. to NA ft., From ft. to ft.
 From ft. to ft., From ft. to ft.
 GRAVEL PACK INTERVALS: From ft. to ft., From ft. to ft.
 From ft. to ft., From ft. to ft.

6 GROUT MATERIAL: 2 Neat cement 13 Cement grout 3 Bentonite 4 Other
 Grout Intervals: From 14 ft. to 13 ft., From ft. to ft., From ft. to ft.

What is the nearest source of possible contamination: 14 Abandoned water well
 1 Septic tank 4 Lateral lines 7 Pit privy 11 Fuel storage 15 Oil well/Gas well
 2 Sewer lines 5 Cess pool 8 Sewage lagoon 12 Fertilizer storage 16 Other (specify below)
 3 Watertight sewer lines 6 Seepage pit 9 Feedyard 13 Insecticide storage

Direction from well? EAST How many feet? 500

FROM	TO	LITHOLOGIC LOG	FROM	TO	PLUGGING INTERVALS
			40	14	CLAY/SUBSOIL
			14	13	CEMENT
			13	0	TOPSOIL

7 CONTRACTOR'S OR LANDOWNER'S CERTIFICATION: This water well was (1) constructed, (2) reconstructed, or (3) plugged under my jurisdiction and was completed on (mo/day/year) 10-8-94 and this record is true to the best of my knowledge and belief. Kansas
 Water Well Contractor's License No. This Water Well Record was completed on (mo/day/yr) 10-17-94
 under the business name of by (signature) Clyde Summer