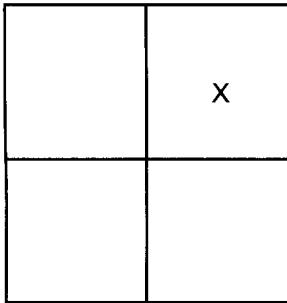


LOCATION OF WATER WELL: RENO	Fraction NC-NE	Section Number 15	Township Number 25 SOUTH	Range Number 04 WEST
--	--------------------------	-----------------------------	------------------------------------	--------------------------------

Distance and direction from nearest town or city street address of well if located within city?
 APPROXIMATELY 1.75 MILES EAST AND 1.25 MILES SOUTH OF HAVEN, KS Latitude: 37.87949 Longitude: -97.74236 (NAD27)

WATER WELL OWNER:
 RR#, St. Address, Box #: David Cranmer
 Cranmer Holdings, LLC
 6121 N. 119th St. W.
 City, State, ZIP Code: Maize, KS 67101
 Board of Agriculture, Division of Water Resources
 Application Number: 46159 (dismissed)

MARK WELL'S LOCATION WITH AN "X" IN SECTION BOX 	DEPTH OF WELL 58.0 ft. WELL'S STATIC WATER LEVEL 32.1 ft. WELL WAS USED AS: <table style="width:100%;"> <tr> <td>1 Domestic</td> <td>5 Public Water Supply</td> <td>9 Dewatering</td> </tr> <tr> <td>2 Irrigation</td> <td>6 Oil Field Water Supply</td> <td>10 Monitoring Well</td> </tr> <tr> <td>3 Feedlot</td> <td>7 Lawn and Garden Only</td> <td>11 Injection Well</td> </tr> <tr> <td>4 Industrial</td> <td>8 Air Conditioning</td> <td>12 Other</td> </tr> </table> Was a chemical/bacteriological sample submitted to Department? Yes ☐ No ☒ If yes, mo/day/yr sample was submitted : / / Water Well Disinfected: Yes ☒ No ☐	1 Domestic	5 Public Water Supply	9 Dewatering	2 Irrigation	6 Oil Field Water Supply	10 Monitoring Well	3 Feedlot	7 Lawn and Garden Only	11 Injection Well	4 Industrial	8 Air Conditioning	12 Other
1 Domestic	5 Public Water Supply	9 Dewatering											
2 Irrigation	6 Oil Field Water Supply	10 Monitoring Well											
3 Feedlot	7 Lawn and Garden Only	11 Injection Well											
4 Industrial	8 Air Conditioning	12 Other											

TYPE OF BLANK CASING USED:

1 Steel	3 RMP (SR)	5 Wrought	7 Fiberglass	9 Other
2 PVC	4 ABS	6 Asbestos-Cement	8 Concrete Tile	

Blank casing diameter 16 in. Was casing pulled? Yes ☐ No ☒ if yes, how much 0.0 ft bls
 Casing height above or below land surface 4.0 feet.

GROUT PLUG MATERIAL: 1 Neat cement 2 Cement grout **3 Bentonite** 4 Other

Grout Plug Intervals: From 32.1 ft. to 4.0 ft.

What is the nearest source of possible contamination:

1 Septic tank	6 Seepage pit	11 Fuel Storage	16 Other
2 Sewer lines	7 Pit privy	12 Fertilizer storage	
3 Watertight sewer lines	8 Sewage lagoon	13 Insecticide storage	
4 Lateral lines	9 Feedyard	14 Abandoned water well	
5 Cess Pool	10 Livestock pens	15 Oil well / Gas well	

Direction from well? None within 1320 ft. How many feet?

FROM	TO	PLUGGING MATERIALS
58.0	32.1	CLEAN, COURSE SAND
32.1	4.0	BENTONITE HOLE PLUG
4.0	0	TOPSOIL

CONTRACTOR'S OR LANDOWNER'S CERTIFICATION: This water well was plugged under my jurisdiction and was completed on (mo/day/year) 11 / 24 / 2010 and this record is true to the best of my knowledge and belief.
 Kansas Water Well Contractor's License No. NA under the business name of
 by (signature) *David Cranmer* David Cranmer, owner

INSTRUCTIONS: Use typewriter or ball point pen. Please press firmly and print clearly. Please fill in blanks, and underline or circle the correct answers. Send top three copies to Kansas Department of Health and Environment, Bureau of Water, Topeka, Kansas 66620-0001. Telephone: 913/296-3565. Send one to Water Well Owner and retain one for your records.

RECEIVED**DEC 23 2010****Equus Beds Groundwater
Management District No. 2**Well plugging witnessed by
David Randolph, GMD2 staff, on 11/24/10