

Harvey

48,759

WATER WELL RECORD


Form WWC-5

Division of Water Resources App. No.

1 LOCATION OF WATER WELL: County: Sedgwick Fraction 1/4 1/4 SW 1/4 SW 1/4 Section Number 33 Township No. T 24 S Range Number R 1 [] E [x] W

Street/Rural Address of Well Location: SW 125th and Emma Creek Global Positioning System (GPS) information: Latitude: Longitude: Elevation: Datum: [] WGS 84, [] NAD 83, [] NAD 27 Collection Method: [] GPS unit, [] Digital Map/Photo, [] Topographic Map, [] Land Survey

2 WATER WELL OWNER: Steve McGinn RR#: 1123 W. 4th St. City, State, ZIP Code: Sedgwick, KS 67135

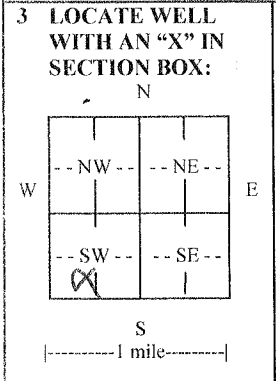

3 LOCATE WELL WITH AN 'X' IN SECTION BOX: 4 DEPTH OF COMPLETED WELL 140 ft. Depth(s) Groundwater Encountered (1) 40 ft. WELL'S STATIC WATER LEVEL 40 ft. below land surface Pump test data: EST. YIELD 270 gpm. Bore Hole Diameter 16 in. to 140 ft. WELL WATER TO BE USED AS: [] Domestic, [] Irrigation, [] Industrial, [] Monitoring well Was a chemical/bacteriological sample submitted? [] Yes [x] No Water well disinfected? [x] Yes [] No

5 TYPE OF CASING USED: [] Steel [x] PVC [] Other CASING JOINTS: [x] Glued [] Clamped [] Welded [] Threaded Casing diameter 8 in. to 140 ft. Casing height above land surface 12 in. TYPE OF SCREEN OR PERFORATION MATERIAL: [] Steel, [] Stainless Steel, [x] PVC, [] Other SCREEN OR PERFORATION OPENINGS ARE: [] Continuous slot, [] Mill slot, [] Gauze wrapped, [] Torch cut, [] Drilled holes, [] None Louvered shutter, [] Key punched, [] Wire wrapped, [x] Saw cut, [] Other GRAVEL PACK INTERVALS: From 20 ft. to 140 ft.

6 GROUT MATERIAL: [] Neat cement, [] Cement grout, [x] Bentonite, [] Other Grout Intervals: From 3 ft. to 20 ft. What is the nearest source of possible contamination: [] Septic tank, [] Lateral lines, [] Pit privy, [] Livestock pens, [] Insecticide storage, [] Other Sewer lines, [] Cesspool, [] Sewage lagoon, [] Fuel storage, [] Abandoned water well Watertight sewer lines, [] Seepage pit, [] Feedyard, [] Fertilizer storage, [] Oil well/gas well Direction from well East Distance from well 1300'

Table with columns: FROM, TO, LITHOLOGIC LOG, FROM, TO, LITHO. LOG (cont.) or PLUGGING INTERVALS. Rows: 0-3 Topsoil, 3-20 Clay, 20-120 Medium Sand, 120-125 Clay, 125-140 Medium Sand, 140 Shale

7 CONTRACTOR'S OR LANDOWNER'S CERTIFICATION: This water well was [x] constructed, [] reconstructed, or [] plugged under my jurisdiction and was completed on (mo/day/year) 12/10/2014 and this record is true to the best of my knowledge and belief. Kansas Water Well Contractor's License No. 238 This Water Well Record was completed on (mo/day/year) 12/12/2014 under the business name of Premier Pump & Well Service, Inc by (signature) [Signature]

INSTRUCTIONS: Use typewriter or ball point pen. PLEASE PRESS FIRMLY and PRINT clearly. Please fill in blanks and check the correct answers. Send one copy to Kansas Department of Health and Environment, Bureau of Water, Geology Section, 1000 SW Jackson St., Suite 420, Topeka, Kansas 66612-1367. Telephone 785-296-5524. Send one copy to WATER WELL OWNER and retain one for your records. Include fee of \$5.00 for each constructed well. Visit us at