


WATER WELL RECORD Form WWC-5

☐ Original Record ☐ Correction ☐ Change in Well Use

Division of Water
Resources App. No.

Well ID

[illegible]

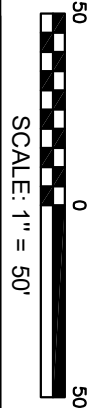

LEGEND

- [Red outline] =Property Boundary
- [Red circle with cross] =Monitoring Well
- [Red circle with dot] =Plugged Monitoring Well
- [Green hatched box] =Gasoline UST
- [Blue hatched box] =Diesel UST
- [Blue circle] =Pump Island
- [Blue circle with dot] =SVE Well
- [Grey circle with dot] =Observation Well
- [Grey circle with cross] =Air Sparge Well

Product Line Locations are Unknown

DRAWN BY:	BG
PROJ. MANGR:	SGE

JOB#:	1874160
DATE:	2019-07-16

Kwik Shop #760
139 South Kansas St.
Haven, Kansas
KDHE#: U2-078-13506/13706

SITE BASE MAP

**GSI**

4903 EAST 47TH STREET SOUTH
WICHITA, KANSAS 67216-1651
Phone: 316-534-0725 • Fax: 316-534-0744

