


WATER WELL RECORD Form WWC-5 KSA 82a-1212

1 LOCATION OF WATER WELL: Fraction Section Number Township Number Range Number
 COUNTY: HAMILTON NE 1/4 NE 1/4 SE 1/4 36 T 25 S R 41 W

Distance and direction from nearest town or city street address of well if located within city?
 FROM SYRACUSE ON HIGHWAY 27 - SOUTH 10 MILES

2 WATER WELL OWNER: HARTSHORN, MELISSA Board of Agriculture, Division of Water Resources
 RR#, St. Address, Box #: PO BOX 790 Application Number:
 City, State, ZIP code: SYRACUSE, KS 67878-

3 LOCATE WELL'S LOCATION WITH AN "X" IN SECTION BOX:

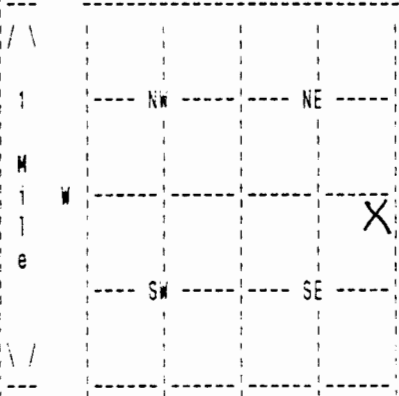

4 DEPTH OF COMPLETED WELL 283 ELEVATION: 0
 Depth(s) Groundwater Encountered 1. 0 ft. 2. 0 ft. 3. 0 ft.

WELL'S STATIC WATER LEVEL 0 ft. below land surface measured on mo/day/yr
 Pump test data: Well water was 0 ft. after 0 hours pumping 0 gpm

Estimated Yield 0 gpm: Well water was 0 ft. after 0 hours pumping 0 gpm

Bore Hole Diameter in. to 0 ft., and in. to 0 ft.

WELL WATER WAS: DOMESTIC

Was a chemical/bacteriological sample submitted to department? No;
 If yes, mo/day/yr sample was submitted Water well disinfected? Yes

5 TYPE OF BLANK CASING USED: CASING JOINTS:
 Blank casing diameter 5 in. to 283 ft., Dia in. to 0 ft., Dia in. to 0 ft.
 Casing height above land surface 0 in., weight 0 lbs/ft. Wall thickness or gauge No.
 TYPE OF SCREEN OR PERFORATION MATERIAL:
 SCREEN OR PERFORATION OPENINGS ARE:

SCREEN PERFORATED INTERVALS: From 0 ft. to 0 ft., From 0 ft. to 0 ft.
 GRAVEL PACK INTERVALS: From 0 ft. to 0 ft., From 0 ft. to 0 ft.
 From 0 ft. to 0 ft., From 0 ft. to 0 ft.

6 GROUT MATERIAL BENTONITE
 Grout Intervals: From 0 ft. to 0 ft., From 0 ft. to 0 ft., From 0 ft. to 0 ft.
 What is the nearest source of possible contamination: NONE - NEW SITE
 Direction from well? How many feet? 0

FROM	TO	LITHOLOGIC LOG	FROM	TO	PLUGGING INTERVALS
			0	6	TOP SOIL & CLAY
			6	25	BENTONITE GROUT
			25	90	FILL SAND
			90	100	BENTONITE GROUT
			100	283	FILL SAND
			0	0	
			0	0	
			0	0	
			0	0	
			0	0	

7 CONTRACTOR'S OR LANDOWNER'S CERTIFICATION: This water well was Plugged under my jurisdiction and was completed on (mo/day/year) 03/10/09 and this record is true to the best of my knowledge and belief. Kansas Water Well Contractor's License No. 179 This Water Well Record was completed on (mo/day/yr) 03/24/09 under the business name of JOE'S WELL SERVICE, INC. by (signature) *Jessie Creek*