


WATER WELL RECORD Form WWC-5 KSA 82a-1212

1 LOCATION OF WATER WELL: Fraction Section Number Township Number Range Number  
 COUNTY: HAMILTON NE 1/4 NE 1/4 SE 1/4 36 T 25 S R 41 W

Distance and direction from nearest town or city street address of well if located within city?  
 FROM SYRACUSE ON HIGHWAY 27 - SOUTH 10 MILES

2 WATER WELL OWNER: HARTSHORN, MELISSA Board of Agriculture, Division of Water Resources  
 RR#, St. Address, Box #: PO BOX 790 Application Number:  
 City, State, ZIP code: SYRACUSE, KS 67878-

3 LOCATE WELL'S LOCATION WITH AN "X" IN SECTION BOX:

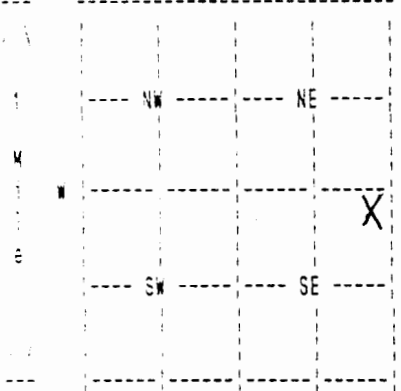

4 DEPTH OF COMPLETED WELL 365 ELEVATION: 0  
 Depth(s) Groundwater Encountered 1. 0 ft. 2. 0 ft. 3. 0 ft.

WELL'S STATIC WATER LEVEL 104 ft. below land surface measured on mo/day/yr 03/10/09  
 Pump testdata: Well water was 0 ft. after 0 hours pumping 0 gpm

Estimated Yield 20 gpm: Well water was 0 ft. after 0 hours pumping 0 gpm

Bore Hole Diameter: 9 in. to 365 ft., and in. to 0 ft.

WELL WATER TO BE USED AS: DOMESTIC

Was a chemical/bacteriological sample submitted to department? No;  
 If yes, mo/day/yr sample was submitted Water well disinfected? Yes

5 TYPE OF BLANK CASING USED: CERTA LOC CASIN CASING JOINTS: CERTA-LOC  
 Blank casing diameter 5 in. to 365 ft., Dia in. to 0 ft., Dia in. to 0 ft.  
 Casing height above land surface 12 in., weight 200 lbs/ft. Wall thickness or gauge No. 21 17  
 TYPE OF SCREEN OR PERFORATION MATERIAL: PVC  
 SCREEN OR PERFORATION OPENINGS ARE: SAW CUT

SCREEN PERFORATED INTERVALS: From 100 ft. to 120 ft., From 300 ft. to 360 ft.  
 From 260 ft. to 280 ft., From 0 ft. to 0 ft.  
 GRAVEL PACK INTERVALS: From 20 ft. to 140 ft., From 0 ft. to 0 ft.  
 From 150 ft. to 365 ft., From 0 ft. to 0 ft.

6 GROUT MATERIAL BENTONITE  
 Grout intervals: From 0 ft. to 20 ft., From 140 ft. to 150 ft., From 0 ft. to 0 ft.  
 What is the nearest source of possible contamination: ABANDONED WELL  
 Direction from well? SOUTH How many feet? 25

FROM	TO	LITHOLOGIC LOG	FROM	TO	PLUGGING INTERVALS
0	20	01 TOPSOIL 21 LIMESTONE 02 FINE SAND			
20	40	02 FINE SAND 32 TAN CLAY 21 LIMESTONE			
40	60	32 TAN CLAY 02 FINE SAND			
60	80	10 FINE-MEDSAND			
80	120	37 FIN-COAR SAN 06 SMALL GRAVEL			
120	160	07 BLUE SHALE			
160	180	36 BLUE CLAY 16 GRAY CLAY 27 ROCK			
180	200	27 ROCK 16 GRAY CLAY			
200	220	16 GRAY CLAY			
220	360	29 SANDSTONE			

7 CONTRACTOR'S OR LANDOWNER'S CERTIFICATION: This water well was Constructed under my jurisdiction and was completed on (mo/day/year) 03/11/09 and this record is true to the best of my knowledge and belief. Kansas Water Well Contractor's License No. 179 This Water Well Record was completed on (mo/day/yr) 03/23/09 under the business name of JOE'S WELL SERVICE, INC. by (signature) *Judith Crick*

(Continued)

WATER WELL RECORD Form WWC-5 KSA 82a-1212

1 LOCATION OF WATER WELL:	Fraction	Section Number	Township Number	Range Number
COUNTY: HAMILTON	NE 1/4 NE 1/4 SE 1/4	36	T 25 S	R 41 W

2 WATER WELL OWNER:	HARTSHORN, MELISSA	Board of Agriculture, Division of Water Resources
RR#, St. Address, Box # :	PO BOX 790	Application Number:
City, State, ZIP code :	SYRACUSE, KS 67878-	

FROM	TO	LITHOLOGIC LOG
360	380	36 BLUE CLAY

7 CONTRACTOR'S OR LANDOWNER'S CERTIFICATION: This water well was Constructed under my jurisdiction and was completed on (mo/day/year) 03/11/09 and this record is true to the best of my knowledge and belief. Kansas water Well Contractor's License No. 179 This Water Well Record was completed on (mo/day/yr) 03/23/09 under the business name of JOE'S WELL SERVICE, INC. by (signature) *Judith Crick*